

CORNER E 1/4 Corner Section 14, T. 19 S., R. 9 W, W.M.
G.L.O. NOTES DATED: _____ BY: _____
CORNER: _____
ACCESSORIES: _____

REESTABLISHMENT NOTES DATED: _____ BY: _____ FILED
EVIDENCE RECOVERED: _____
Date: 10-16-2013 By: JL

CORNER SET: _____
ACCESSORIES ESTABLISHED: _____
This survey consists of:
Map: _____
Corner: C.S. 65/80-8

REESTABLISHMENT NOTES DATED: _____ BY: _____
EVIDENCE RECOVERED: _____ DOUGLASS COUNTY
SURVEYOR

CORNER SET: _____
ACCESSORIES ESTABLISHED: _____

REESTABLISHMENT NOTES DATED: _____ BY: _____
EVIDENCE RECOVERED: _____

CORNER SET: _____
ACCESSORIES ESTABLISHED: _____


REMONUMENTATION

DATE: May 2002 BY: Rob Ward TITLE: President FIRM: Wood North West Inc.
EVIDENCE RECOVERED: 2-1/2" dia. Brass Cap dated 1958
27" Fir - Now uprooted
19" Fir bears S 84-1/4° W, 17.7 FT Now ~~is~~ high stump with visible scribbling

CORNER SET: N/A

ACCESSORIES ESTABLISHED:
10" Alder bears N 76 1/4° E, 24.3 FT Scribed "1/4 S13 BT"
10" Hemlock bears N 79 1/2° W, 23.8 FT Scribed "1/4 S14 BT"
10" Hemlock bears S 71 1/2° E, 31.3 FT Scribed "1/4 S13 BT"

OTHER INFORMATION: _____

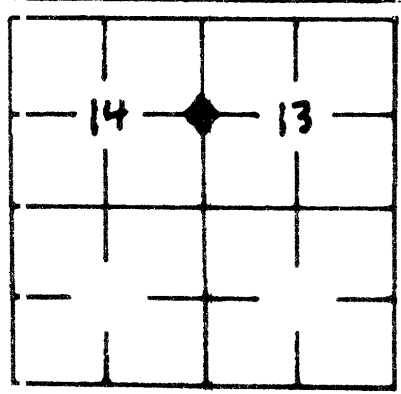

SECTION DIAGRAM

T 19 S R 9 W
1/4
S14 | S13
1958

