

CORNER REPORT FORM

Section 2 Township 32S Range 8W
Douglas County Date 9-2013

CORNER DESIGNATION

NW 1/4

Condition Report only
Not Found
Renewed
Unrecorded
Surveyed In
Referenced out

Previous Renewals/Surveys, etc:

MB3-26

Monument(s) & Accessories Found: (Condition and Source)

Fd 5/8" I. ROD & ALUMI CAP

10" FIR 54°E 22³ FT

26" FIR N59W 20⁵ FT

FILED

Date: 10-16-2013 By: SC

This survey consists of:

Map: _____

Narrative: _____

Corner Rpt: CS 65/80-13

DOUGLAS COUNTY
SURVEYOR

Monument Detail

Sketch

Monument Set (Procedures and Description)

New Accessories

Set Alum post 2' EAST
ReTAG Both Trees

Location & Comments

AREA BURN

1-2013

Compass Declination 15¹/₂

Firm/Agency: i.e. Engineering, Inc.


Address: 809 SE Pine St.
Roseburg, OR 97470

Party Chief: J. LEONARD

Notes:

Witness: N. From dahl

Surveyor's Seal

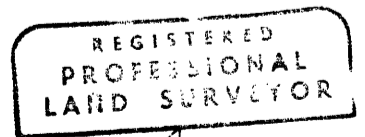

Ronald A. Quimby
OREGON
JULY 16, 1978
RONALD A. QUIMBY
1654

C.S. File No 65/80-13

EXP 12-31-14