

CORNER REPORT FORM

Section 2 Township 32 Range EW
Douglas County Date 9-26-13

CORNER DESIGNATION

CN 1/16

Condition Report only
Not Found
Renewed
Unrecorded
Surveyed In
Referenced out

Previous Renewals/Surveys, etc:

111 83-26

Monument(s) & Accessories Found: (Condition and Source)

Fd 5/8" I. ROD & ALUM CAP
Fd 10" OAK SB 9 W 93 FT
10" FIR N 11 E 193 FT

FILED

Date: 10-16-2013 By: SC
This survey consists of:
Map: _____
Narrative: _____
Corner Rpt: CS 65/80-16

DOUGLAS COUNTY
SURVEYOR

Monument Detail

Sketch

Monument Set (Procedures and Description)

New Accessories

Set Alum Post 2' south & 2' west
Re TAG Both Trees

Location & Comments

Area Burnt
7-2013

Compass Declination 15 1/2
Firm/Agency: i.e. Engineering, Inc.



Address: 809 SE Pine St.
Roseburg, OR 97470

Party Chief: J. LEONARD

Notes:

Witness: N. Fromdahl

Surveyor's Seal

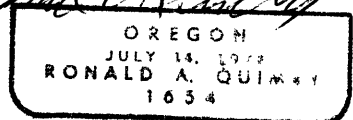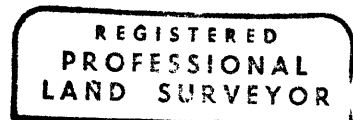

EXP 12-31-14

C.S. File No 65/80-16