

FILED OCT 21 2013

CORNER REPORT FORM

Section 18 Township 32S Range 7W
Douglas County Date 10-2013

CORNER DESIGNATION

140500

Condition Report only
Not Found
Renewed
Unrecorded
Surveyed In
Referenced out

Previous Renewals/Surveys, etc:

BLM 1978

Monument(s) & Accessories Found: (Condition and Source)

FD BLM BRASS CAP
10" LIVE OAK N55'SW 44' FT HEALED FACE
16" FIR S7E 26' FT HEALED FACE

Monument Detail

Sketch

U.S Dept of Interior
T 32S R 7W

1/4 57
513
1978
BLM

FILED

Date: 10/21/2013 By: X

This survey consists of:

Map: _____

Narrative: _____

Corner Rpt: CS65/80-29

Monument Set (Procedures and Description)

DOUGLAS COUNTY
SURVEYOR

New Accessories

Location & Comments

Set Alum post
2 FT. EAST & WEST
OF CORNER
AREA BURNED
7/2013

Compass Declination

Firm/Agency: i.e. Engineering, Inc.

Address: 809 SE Pine St.
Roseburg, OR 97470


Party Chief:

Notes:

Witness:

Surveyor's Seal

REGISTERED
PROFESSIONAL
LAND SURVEYOR

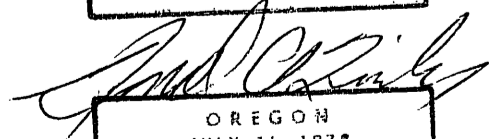

OREGON
JULY 14, 1978
RONALD A. QUIMBY
1634

EXP 12-31-14

C.S. File No 65/80-29