

CORNER REPORT FORM

FILED OCT 21 2013

Section 18 Township 32S Range 7W
Douglas County Date 10-2013

CORNER DESIGNATION

200440

Condition Report only

- Not Found
- Renewed
- Unrecorded
- Surveyed In
- Referenced out

Previous Renewals/Surveys, etc:

200440 Estabrook 4/2003 CS File 65/45-23
BLM

Monument(s) & Accessories Found: (Condition and Source)

FD BLM BRASS CAP
 A 10" D. FIR N37E 31.2 FT Healed FACE
 A 10" D. FIR N153W 14.2 FT " "
 A 20" Pine 55W 18.2 FT " "
 A 20" D. FIR S75E 35.2 FT " "

Monument Detail

Sketch

US DEPT OF INTERIOR
 T32S R7W
 1/4
 S18/S17
 BLM

FILED
 Date: 10/21/2013 by: X
 This survey consists of:
 Map: _____
 Narrative: _____
 Corner Rpt: CS 65/80-30

DOUGLAS COUNTY SURVEYOR

Monument Set (Procedures and Description)

New Accessories

Set Alum post 20 North & South
Retag Trees

Location & Comments

Surveyor's Seal

See CS File
65/45-23
AREA BURNED
7/2013

Compass Declination


Firm/Agency: i.e. Engineering, Inc.

Address: 809 SE Pine St.
Roseburg, OR 97470

Party Chief: J. Leonard

Notes:

Witness: N. Fromdahl

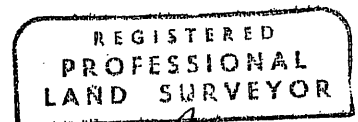

Ronald A. Quimby
 OREGON
 JULY 14, 1978
 RONALD A. QUIMBY
 1654

EXP 12-31-14

C.S. File No 65/80-30