

CORNER REPORT FORM

FILED OCT 21 2013

Section 18 Township 32S Range 7W
Douglas County Date 10-2013

CORNER DESIGNATION

200500

Condition Report only

Not Found
Renewed
Unrecorded
Surveyed In
Referenced out

Previous Renewals/Surveys, etc:

BLM 1978

Monument(s) & Accessories Found: (Condition and Source)

Fd 1978 BLM BRASS CAP
A 14" fir N32E 31' Healed FACE
A 20" fir S34E 36' " "
A 24" fir S59W 61' " "
A 12" fir N56W 16' " "

Monument Detail

Sketch

U.S. Dept Interior
T32S R7W
57/58
518/517
1978
BLM

FILED

Date: 10/21/2013 By: SC
This survey consists of:
Map: _____
Narrative: _____
Corner Rpt: 65/80-31

DOUGLAS COUNTY
SURVEYOR

Monument Set (Procedures and Description)

New Accessories

Set Alum post 2° west & 2° south
Retag Trees

Location & Comments

Surveyor's Seal

AREA BURNED
7/2013



Compass Declination
Firm/Agency: i.e. Engineering, Inc.

Address: 809 SE Pine St.
Roseburg, OR 97470

Party Chief: J. Leonard

Notes:

Witness: N. Fromm

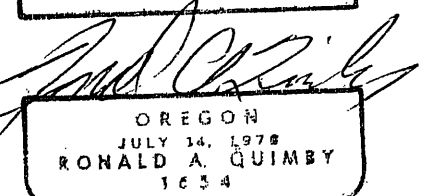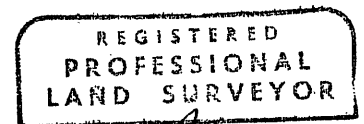

EXP 12-31-14

C.S. File No 65/80-31