

CORNER REPORT FORM

Section 1 Township 32S Range 8W
Douglas County Date 10-2013

CORNER DESIGNATION

C.S. 1/16 S1

Condition Report only
Not Found
Renewed
Unrecorded
Surveyed In
Referenced out

Previous Renewals/Surveys, etc:

1M 83-25

Monument(s) & Accessories Found: (Condition and Source)

FD Alum Cap on 5/8 Rebar (Badly bent)
A 7' Burnt ^{10"} Stump S30W 185 FT (RT TAGS ON GROUND)
A 7' Burnt Stump 10" N41°E 365 FT

FILED

Date: 11/1/2013 By: JC
This survey consists of
Map: _____
Narrative: _____
Corner Rpt: CS65/80-38

Monument Detail

Sketch

DOUGLAS COUNTY
SURVEYOR

T 32S R 8W Sec 1

C.S. 1/16
1980
L3 498

Monument Set (Procedures and Description)

New Accessories

Set Alum post 20 North & 20 West
Re-tag Stumps

Location & Comments

CORNER IS ON
A Steep South
Slope approx
400' West of
ROAD AREA Badly
Burnt 7-2013

Compass Declination 15 1/2
Firm/Agency: i.e. Engineering, Inc.



Address: 809 SE Pine St.
Roseburg, OR 97470

Party Chief: J. Leonard

Notes:

Witness: N. Fjordahl

Surveyor's Seal

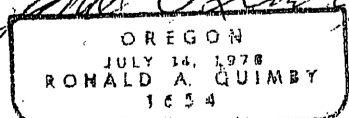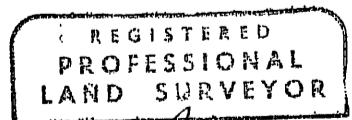

EXP 12-31-14

C.S. File No 65/80-38