

CORNER REPORT FORM

Section 22 Township 32S Range 8W

Douglas County

Date 11-2013

CORNER DESIGNATION

500400

Condition Report only

- Not Found
- Renewed
- Unrecorded
- Surveyed In
- Referenced out

Previous Renewals/Surveys, etc:

M. LARSON 1954 CS 41/289

DCSD 1968 CS 54/65

BLM 1975

DCSD 1992 CS 64-39

Monument(s) & Accessories Found: (Condition and Source)

2 1/2" I.Pipe with BRASS CAP

A 30" fir N35E 43⁶ FT HEALED FACE

A 26" fir S79E 47⁵ FT " "

A 36" Sugar Pine S57W 86⁸ FT HEALED FACE

A 28" fir N 57W 47⁵ FT " "

Monument Detail

Sketch

BLM BRASS CAP

T32S R8W

S15/S14

S22/S23

1975

FILED

Date: 11/12/2013 By: JC

This survey consists of:

Map: _____

Name: _____

Corner Rpt: CS 65/80-41

Monument Set (Procedures and Description)

DOUGLAS COUNTY
SURVEYOR

New Accessories

Set Alum Post 2° west

Location & Comments

AREA BURNED

8-2013

Surveyor's Seal

Compass Declination 15°



Firm/Agency: i.e. Engineering, Inc.

Address: 809 SE Pine St.
Roseburg, OR 97470

Party Chief: J. LEONARD

Notes:

Witness: N. Fromdahl

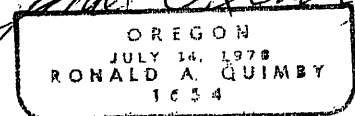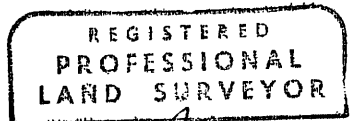

EXP 12-31-14

C.S. File No CS/80-41