

CORNER REPORT FORM

Section 1 Township 32S Range 8W

Douglas County Date 11-2013

CORNER DESIGNATION

700600

Condition Report only

- Not Found
- Renewed
- Unrecorded
- Surveyed In
- Referenced out

Previous Renewals/Surveys, etc:

DCSO 1968 Hull m 108-69  
BLM 1973

Monument(s) & Accessories Found: (Condition and Source)

Fd DCSO BRASS CAP  
 A 20" fir N64°E 30° Healed FACE  
 A 20" fir N56W 14° " "  
 A 26" fir S42W 19° " "  
 A 14" MADRONA S41°E 4' Vis. Scribes

Monument Detail

Sketch

COUNTY SURVEYORS OFFICE  
 R T 32S R  
 B 51 / 56 7  
 W 512 / 57 W  
 1968

FILED

Date: 11-13-2013 By: X  
 This survey consists of:  
 Map: \_\_\_\_\_  
 Narrative: \_\_\_\_\_  
 Corner Rpt: CS 65/80-42

Monument Set (Procedures and Description)

DOUGLAS COUNTY SURVEYOR

New Accessories

Set 6' Alum Post 20 west  
 Re TAG Trees

Location & Comments

AREA BURNED  
 7-2013

Surveyor's Seal



Compass Declination 15°  
 Firm/Agency: i.e. Engineering, Inc.

Address: 809 SE Pine St.  
 Roseburg, OR 97470

Party Chief: J. Leonard

Notes:

Witness: N. Fromdahl

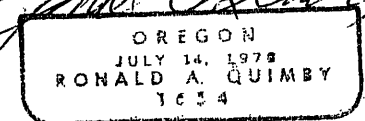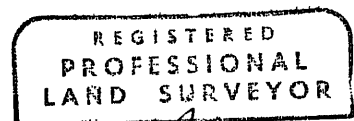

C.S. File No 65/80-42

EXP 12-31-14