

FILED

Date: 11-14-2013 By: SC

This survey consists of:

Map: _____

Narrative: _____

Corner Rpt: CS 65/86-44

DOUGLAS COUNTY
SURVEYOR

CORNER REPORT FORM

Section 4 Township 33 S Range 7 W
Douglas County Date Nov. 8, 2013
PLSS Number 400540

CORNER DESIGNATION

1/4 corner common to Sections 4 and 5.

- ___ Condition Report only
- ___ Not Found
- ___ Renewed
- ___ Unrecorded
- ___ Surveyed In
- ___ Referenced out

Previous Renewals/Surveys, etc:

Original: Thiel, 1900.
Pipe set on CS 41/301. Not found DCS crew 1968.

Monument(s) & Accessories Found: (Condition and Source)

Found 1 1/2 inch diameter iron pipe.

Monument Detail

N/A

Sketch

Monument Set (Procedures and Description)

N/A


New Accessories

A dead 12" diameter Fir bears N.5°E., 19.4 feet. (corner is in burned area).
A 7" diameter Fir bears N.46°W., 38.4 feet. Scribed "1/4 S4 BT".
Scribed "1/4 S4 BT"

Surveyor's Seal

Location & Comments

Compass Declination 15 1/4 East
Firm/Agency: David Edwards Land Surveying
Address: P.O. Box 361
Oakland, Oregon 97462
Party Chief: Brant Miller
Notes: Eric Sprinkle
Witness: _____

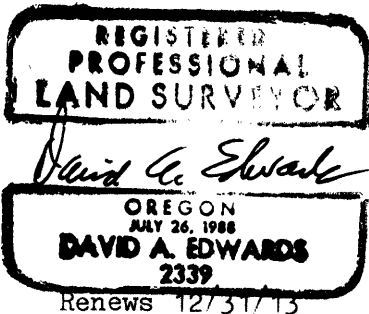

C.S. File 65/80-44