

FILED

Date: 11/14/2013 By: SC
This survey consists of:

Map: _____

Narrative: _____
Corner Rpt: CS 65/80-45

DOUGLAS COUNTY
SURVEYOR

CORNER REPORT FORM

Section 4 Township 33 S Range 7 W
Douglas County Date Nov. 6, 2013
PLSS Number _____

CORNER DESIGNATION

CN 1/16 per CS 41/301

- ___ Condition Report only
- ___ Not Found
- X Renewed
- ___ Unrecorded
- ___ Surveyed In
- ___ Referenced out

Previous Renewals/Surveys, etc:

CS 41/301

Monument(s) & Accessories Found: (Condition and Source)


No monument found.

Found 24" diam. high stumped Fir with healed blaze S.59 $\frac{1}{2}^{\circ}$ E., 61.4 feet.
Found burned fir stump S.40 $\frac{1}{2}^{\circ}$ W., 27.1 feet to approx. center.

Corner lies 10 feet West of gravel road.

Monument Detail

Sketch

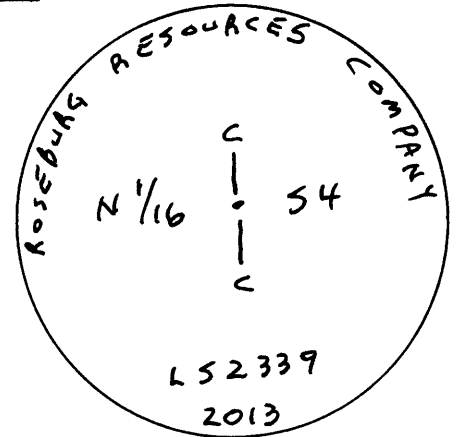

Monument Set (Procedures and Description)

Set a 5/8" x 30" steel rebar with a 2 $\frac{1}{2}$ " diam. aluminum cap marked as shown from bearing trees listed above from CS 41/301 record data.


New Accessories

No live trees available due to fire activity.
Set 6 foot steel post 2 feet S.88 $\frac{1}{2}^{\circ}$ E. and
Set 6 foot steel post 2 feet N.88 $\frac{1}{2}^{\circ}$ W.

Surveyor's Seal

Location & Comments

Compass Declination 15 $\frac{10}{4}$ E
Firm/Agency: David Edwards Land Surveying
Address: P.O. Box 361
Oakland, OR. 97462
Party Chief: Brant Miller
Notes: Eric Sprinkle
Witness: _____

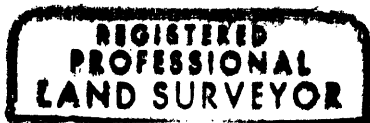

David A. Edwards
OREGON
JULY 26, 1988
DAVID A. EDWARDS
2339

Renews 12/31/13

C.S. File 65/80-45