

FILED

Date: 11-14-2013 By: SC

This survey consists of:

Map: \_\_\_\_\_

Narrative: \_\_\_\_\_

Corner Rpt: CS 65/80-46

CORNER REPORT FORM

Section 4 Township 33 S Range 7 W  
Douglas County Date Nov. 8, 2013  
PLSS Number \_\_\_\_\_

DOUGLAS COUNTY  
SURVEYOR

CORNER DESIGNATION

CW 1/16 corner

- \_\_\_ Condition Report only
- \_\_\_ Not Found
- X Renewed
- \_\_\_ Unrecorded
- \_\_\_ Surveyed In
- \_\_\_ Referenced out

Previous Renewals/Surveys, etc:

CS 41/301

Monument(s) & Accessories Found: (Condition and Source)

1 inch (outside) diameter iron pipe. BT's down.

Monument Detail

Sketch

N/A

Monument Set (Procedures and Description)

N/A

New Accessories

The Northwest fork of a double Madrone, 12 inches in diameter bears N.76°E., 37.6 feet. Scribed "CW 1/16 S 4 BT". Both.

A 13 inch diameter Pine bears S.4°W., 19.4 feet.

Surveyor's Seal

Location & Comments

Compass Declination 15<sup>10</sup>/<sub>4</sub> East

Firm/Agency: David Edwards Land Surveying


Address: P.O. BOX 361

Oakland, Oregon 97462

Party Chief: Brant Miller

Notes: Eric Sprinkle

Witness: \_\_\_\_\_

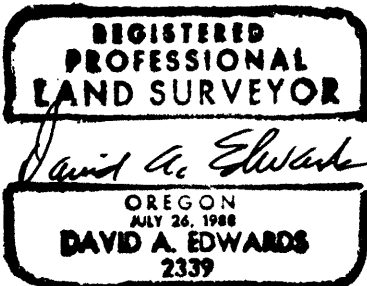

Renews 12/31/13

C.S. File 65/80-46