

CORNER REPORT FORM

FILED

Section 28 Township 31S Range 8W  
Douglas County Date 12/2013  
PLSS Number 340300

Date: 12/19/2013 By: JC  
This survey consists of:  
Map: \_\_\_\_\_  
Narrative: \_\_\_\_\_  
Corner Rpt: CS 65/80-62  
DOUGLAS COUNTY  
SURVEYOR

CORNER DESIGNATION

1/4 COR 21  
28

- \_\_\_ Condition report only
- \_\_\_ Not Found
- \_\_\_ Renewed
- \_\_\_ Unrecorded
- \_\_\_ Surveyed In
- \_\_\_ Referenced out


Previous Renewals/Surveys, etc:

DCSO 1958 CS File 49/109  
M 87-74

Monument(s) & Accessories Found: (Condition and Source)

DCSO BRASS CAP  
18" FIR (SQA 7' TALL) N 62 E 10.6 FT WITH SCAR  
14" FIR (SQA 8' TALL) S 78 E 10.4 FT WITH SCAR  
16" FIR S 20 E 7.9 FT GOOD SCAR  
All trees badly burnt.

Monument Detail

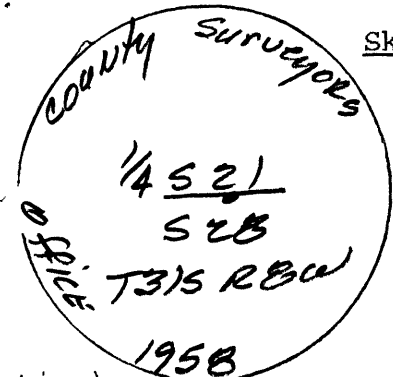

Monument Set (Procedures and Description)

New Accessories


Set Alum Post 2' south

Surveyor's Seal

Location & Comments

AREA badly  
Burnt 8/2013

Compass Declination 15°  
Firm/Agency: 12 engineering  
Address: 8095 E Ave  
Roseburg  
Party Chief: J. LEONARD  
Notes:  
Witness: N From Dahl

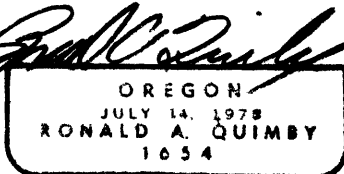

C.S. File EXP 12-31-14  
CS 65/80-62