

CORNER REPORT FORM

FILED

Section 28
Douglas County
PLSS Number

Township 31S Range 8W
Date 12/2013

Date: 12/19/2013 By: DC
This survey consists of:
Map: _____
Narrative: _____

340260

Corner Rpt: CS65/80-63
DOUGLAS COUNTY
SURVEYOR

CORNER DESIGNATION

CN 1/16 S 28

- Condition report only
- Not Found
- Renewed
- Unrecorded
- Surveyed In
- Referenced out


Previous Renewals/Surveys, etc:

M 87-74

Monument(s) & Accessories Found: (Condition and Source)

5/8" I. ROD with Alum CAP
A 24" fir N SBE 12⁵ FT Healed SCAR
A 12" fir S 13W 22⁵ FT Healed SCAR

Monument Detail

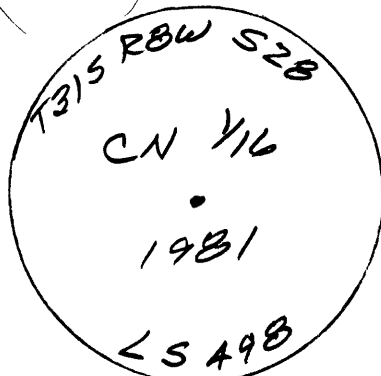

Sketch

Monument Set (Procedures and Description)

New Accessories


set Alum Post 2' N & S.
Retag Trees

Surveyor's Seal

Location & Comments

AREA badly
Burnt 8/2013

Compass Declination 15°
Firm/Agency: 1c engineering
Address: 809 S.E. Pine St
Roseburg
Party Chief: J. LEONARD
Notes:
Witness: N Cromdahl

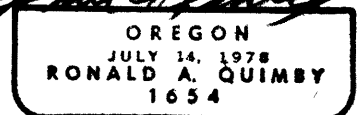

EXP 12-31-14

C.S. File CS65/80-63