

MAP OF SURVEY


LOCATED in Sec. 30, T. 24 S., R.3W., W.M. in Douglas Co., Ore.

Date: 4-7-2014 By: Jc
 This survey consists of:
 Map: 65/81-10
 Narrative: _____
 Corner Rpt: _____

DOUGLAS COUNTY
SURVEYOR



David A. Edwards

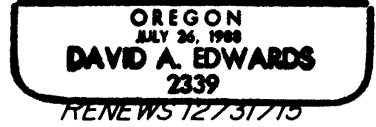

SURVEYED FOR: *SENECA JONES TIMBER CO.*
P.O. BOX 2129
ROSEBURG, OREGON 97470

SURVEYED BY: *DAVID EDWARDS LAND SURVEYING*
P.O. BOX 361
OAKLAND, OREGON 97462
PHONE: (541) 459-0512

LEGEND

- ⊙ INDICATES B.L.M. BRASS CAP FOUND. SCALE: 1" = 1000' SURVEY DATE: MARCH, 2014.
- () DENOTES RECORD DATA PER 1950 B.L.M. RESURVEY. H.B. = HEALED BLAZE.
- BASIS OF BEARINGS: EXISTING CONTROL PER C.S. 65/75-2.

NARRATIVE

THE PURPOSE OF THIS SURVEY IS TO MARK A PORTION OF THE WEST LINE OF SECTION 30. THE MARKING WAS ACCOMPLISHED BY BLAZING TREES ON EACH SIDE OF LINE, BY SETTING 6 FOOT STEEL POSTS ALONG LINE AT INTERVALS OF 200' OR LESS AND BY HANGING LIBERAL AMOUNTS OF RED FLAGGING ALONG THE TRUE LINE.

FIELD CREW: BRANT MILLER AND ERIC SPRINKLE.

EQUIPMENT: NIKON TOTAL STATION.

COMPUTATIONS AND DRAFTING: DAVID EDWARDS.

