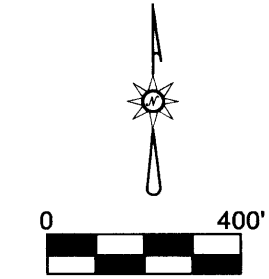
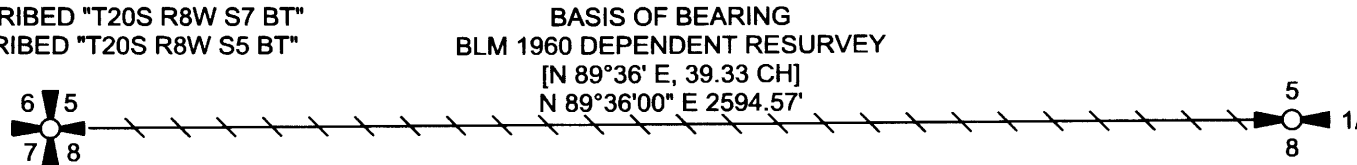


RECORD OF SURVEY  
 FOR: OXBOW TIMBER 1 LLC  
 NW1/4 SEC. 8, T20S R8W W.M.  
 DOUGLAS COUNTY, OR  
 3/17/2014

FILED  
 DATE: 4/24/2014 BY: JC  
 THIS SURVEY CONSISTS OF:  
 MAP: CS 65/81-12  
 NARRATIVE: \_\_\_\_\_  
 CORNER RPT: \_\_\_\_\_  
 DOUGLAS COUNTY  
 SURVEYOR

SECTION CORNER 5/6/7/8  
 FND: BLM BRASS CAP DATED 1954  
 WITH THE FOLLOWING ACCESSORIES;  
 35" D-FIR ROTTED STUMP BEARS S60°W, 17LKS  
 24" ROTTED D-FIR STUMP BEARS S80°E, 12 LKS  
 NEW BT'S THIS SURVEY;  
 17" D-FIR BEARS N44°W, 3.6' - SCRIBED "T20S R8W S6 BT"  
 22" D-FIR BEARS S79°W, 36.5' - SCRIBED "T20S R8W S7 BT"  
 21" D-FIR BEARS S31°W, 27.7' - SCRIBED "T20S R8W S7 BT"  
 20" D-FIR BEARS N69°E, 25.6' - SCRIBED "T20S R8W S5 BT"

1/4 CORNER 5/8  
 FND: BLM BRASS CAP DATED 1954  
 WITH THE FOLLOWING ACCESSORIES;  
 23' D-FIR SNAG BEARS S54-1/4°W, 47.5' - SCIBING VISIBLE  
 31" BURNT CEDAR STUMP BEARS N59°W, 46.2'  
 19" D-FIR BEARS S17°E, 12.2' - SCRIBING VISIBLE  
 9" D-FIR BEARS N7-1/2°W, 23.0' - SCRIBING VISIBLE  
 NEW BT THIS SURVEY;  
 23" D-FIR BEARS N74°E, 12.1' - SCRIBED "1/4 S5 BT"



**NARRATIVE**

THE PURPOSE FOR FILING THIS SURVEY IS TO DOCUMENT A PROPERTY LINE SURVEY FOR OXBOW TIMBER 1 LLC, THAT WAS PERFORMED IN APRIL OF 2012. OXBOW TIMBER HAS REQUESTED THAT ALL SURVEY WORK PERFORMED FOR THEM BETWEEN 2011 AND 2014 BE SHOWN IN A RECORD OF SURVEY. WHEN THE SURVEY WAS PERFORMED, NO CORNERS WERE SET, ONLY PROPERTY LINES WERE MARKED AS NOTED HEREON.



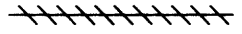

THIS SURVEY RESULTED IN MARKING THE TRUE LINE BETWEEN EXISTING CORNERS AS SHOWN HEREON.

EXISTING CORNERS WERE TIED BY GROUND TRAVERSE FOR CONTROL AND HELD IN THEIR AS TIED POSITIONS FOR MARKING TRUE LINE. TRUE LINE WAS MARKED WITH RED PAINTED BLAZES, RED FLAGGING AND 5-1/2' GALVANIZED STEEL POSTS SET AT AN AVERAGE INTERVAL OF 200'.

THE BASIS OF BEARING FOR THIS SURVEY IS AS NOTED HEREON.

THIS SURVEY WAS PERFORMED USING A NIKON TOTAL STATION.

**LEGEND**

-  FND; 1/4 CORNER
-  FND: SECTION CORNER
-  PROPERTY LINE BLAZED, PAINTED FLAGGED & POSTED
-  BLM 1960 RECORD DATA

REGISTERED  
 PROFESSIONAL  
 LAND SURVEYOR  
*Robert B. Ward Jr.*  
 OREGON  
 ROBERT B. WARD JR.  
 JULY 30, 1976  
 LS 1091

EXPIRATION DATE: 6/30/14

 NORTHWEST Land Surveying, Inc.  
 (541) 997-9201  
 www.northwestlandsurveying.com  
 P.O. Box 2827  
 Florence, OR 97439  
 Fax (541) 902-0743

JOB 12-14