

CORNER REPORT FORM

FILED

Date: 1-8-2014 By: JC

Section 26 Township 32 Range 7W

This survey consists of:

Douglas County Date 1-2014

Map: _____

PLSS Number 600200

Narrative: _____
Corner Rpt: CS 65/82-3

DOUGLAS COUNTY
SURVEYOR

CORNER DESIGNATION

Sec Cor 26/25
35 36

- Condition report only
- Not Found
- Renewed
- Unrecorded
- Surveyed In
- Referenced out

Previous Renewals/Surveys, etc:


DCSO 1968
BLM Dependent Resurvey 2002 M 156-10 2008
DCSO-SIS 2004 CS File 67/33-1

Monument(s) & Accessories Found: (Condition and Source)

FD DCSO BRASS CAP.
24" PINE N45E 33° GOOD SCAR
52" Fir N14W 13° FT " "
20" MADRONA SNAG 6'TALL S33W 76° FT
18" Fir STUMP S50°E 52.8 FT

Monument Detail

Sketch

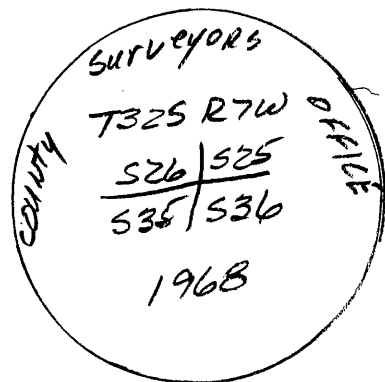

Monument Set (Procedures and Description)



New Accessories

Surveyor's Seal

Location & Comments

CORNER ON S.E.
Slope Approx 400'
EAST OF GRUEL RD
AREA BURNED 8/2013

Compass Declination 15 1/2
Firm/Agency: 1E ENGINEERING
Address: 209 S.E. PINE ST
Roseburg
Party Chief: J. LEONARD
Notes: N FROM
Witness:

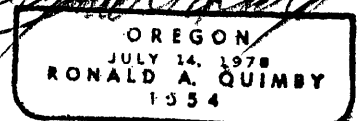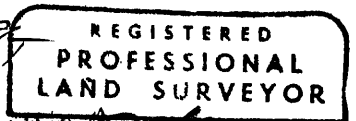

C.S. File 65/82-3 EXPI 12-31-14