

CORNER REPORT FORM

FILED

Date: 1-8-2014 By: JL

Section 26 Township 32 Range 7W

This survey consists of:

Douglas County Date 1/2014

Map: \_\_\_\_\_

PLSS Number 540200

Narrative: \_\_\_\_\_

Corner Rpt: CS 65/82-4

DOUGLAS COUNTY  
SURVEYOR

CORNER DESIGNATION

1/4 COR 26  
35

- Condition report only
- Not Found
- Renewed
- Unrecorded
- Surveyed In
- Referenced out

Previous Renewals/Surveys, etc:


DCSO 1968  
M 94-27 1983  
BLM 2002

Monument(s) & Accessories Found: (Condition and Source)

FD DCSO BRASS CAP  
32" FIR N61E 17<sup>B</sup> FT GOOD SCAR  
21" FIR S59E 26<sup>S</sup> FT GOOD SCAR  
42" FIR SBW 19<sup>B</sup> FT GOOD SCAR

Monument Detail

Sketch

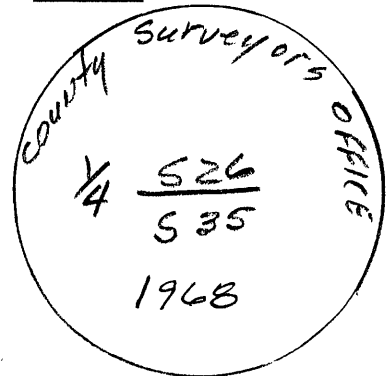

Monument Set (Procedures and Description)

New Accessories


Surveyor's Seal

Location & Comments

CORNER ON WEST  
FACING HILLSIDE  
300' EAST OF  
PANTHER CR. AREA  
BURN'T 8/2013

Compass Declination 15 1/2  
Firm/Agency: IC ENGINEERING  
Address: 809 S.E. PINE ST.

Party Chief: J. LEONARD  
Notes:  
Witness: N FROM WHA!

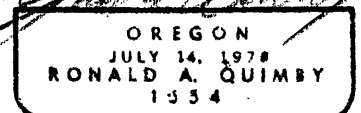

*[Handwritten signature]*  
EXP 12-31-14

C.S. File 65/82-4