

FILED

Date: 1-15-2014 By: JC

This survey consists of:

Map: _____

Narrative: _____

Corner Rpt: 65 65/82-13

DOUGLAS COUNTY
SURVEYOR

CORNER REPORT FORM

Section 36 Township 24 S Range 3 W
Douglas County Date 1/11/2014
PLSS Number 700100

CORNER DESIGNATION

SE corner Section 36.
Township Corner.

- ___ Condition Report only
- ___ Not Found
- X Renewed
- ___ Unrecorded
- ___ Surveyed In
- ___ Referenced out


Previous Renewals/Surveys, etc:

Original: W.H. Byars, 1871. Resurvey by Norman D. Price in 1943.
Resurvey by Tallett and White in 1951. D.C.S. renewal in 1966.

Monument(s) & Accessories Found: (Condition and Source)

Found 1943 G.L.O. Brass Cap.
50" diam. Fir stump bears N.50 $\frac{1}{2}$ °W., 42.2 feet. No marks visible.
54" diam. Fir stump bears N.37°E., 26.4 feet. No marks visible.
Found a steel fence post set 1 foot m/l South of brass cap.

Monument Detail

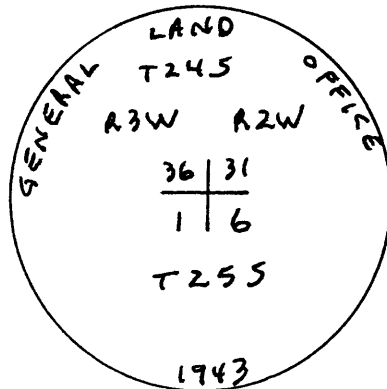

Sketch

Monument Set (Procedures and Description)

N/A

Set a 5.5' tall steel channel post 2.0' North of brass cap.

New Accessories

- A 17" diam. Fir scribed "T24S R2W S31 BT" bears N.52°E., 48.4 feet.
- A 27" diam. Fir scribed "T25S R2W S6 BT" bears S.44°E., 6.0 feet.
- A 19" diam. Fir scribed "T25S R3W S1 BT" bears S.43°W., 37.4 feet.
- A 21" diam. Fir scribed "T24S R3W S36 BT" bears N.10°W., 29.1 feet.

All measurements to 16d nail in tree side center.

Surveyor's Seal

Location & Comments

Compass Declination 15 $\frac{1}{4}$ ° East

Firm/Agency: David Edwards Land Surveying

Address: P.O. Box 361

Oakland, Oregon 97462


Party Chief: David Edwards

Notes: same

Witness: Brant Miller



David A. Edwards

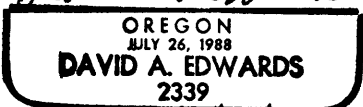

Renews 12/31/15

C.S. File 65/82-13