

CORNER REPORT FORM

FILED

Section 24
Douglas County
PLSS Number

Township 31S Range 8W
Date 2-2014

700340

Date: 2-25-2014 By: JC
This survey consists of:
Map: _____
Narrative: _____
Corner Rpt: CS 65/82-22

DOUGLAS COUNTY
SURVEYOR

CORNER DESIGNATION

1/4 COR S24 T31S R8W
S19 T31S R7W

- Condition report only
- Not Found
- Renewed
- Unrecorded
- Surveyed In
- Referenced out

Previous Renewals/Surveys, etc:

M 65-5

Monument(s) & Accessories Found: (Condition and Source)

Fd 5/8" I. ROD with ALUMI CAP
1A" D FIR N81°E 27? FT GOOD SCAR
2A" FIR STUMP (6' TALL) N83W 32 FT BADLY BURNT

Monument Detail



Sketch

Monument Set (Procedures and Description)

New Accessories



8" D. FIR S14°E 21 1/2 FT scribed 1/4 S19 BT
4" D FIR S52W 39 1/2 FT scribed 1/4 S24 BT

Surveyor's Seal

Location & Comments

Compass Declination 15 1/2
Firm/Agency: IE ENG
Address:

Party Chief: J. LEONARD
Notes:
Witness: N. Fromdah

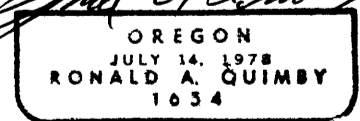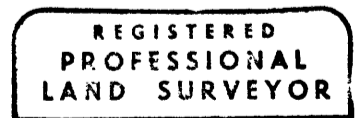

EXP 12-31-14

C.S. File 65/82-22