

CORNER REPORT FORM

FILED

Section 10 Township 33 Range 7  
Douglas County Date 4-2014  
PLSS Number 420560

Date: 4/10/2014 By: JC

This survey consists of:

Map: \_\_\_\_\_

Narrative: \_\_\_\_\_

Corner Rpt: CS 65/82-29

DOUGLAS COUNTY  
SURVEYOR

CORNER DESIGNATION

N.W 1/16 510

- Condition report only
- Not Found
- Renewed
- Unrecorded
- Surveyed In
- Referenced out

Previous Renewals/Surveys, etc:

M 98-47

Monument(s) & Accessories Found: (Condition and Source)

FD 3 3/4" Alum CAP  
22" FIR S 74 W 36.5 FT GOOD SCAR  
13" FIR S 5 E 20.5 FT GOOD SCAR

Monument Detail



Sketch

Monument Set (Procedures and Description)

New Accessories



Location & Comments

AREA BURNED  
8-2013

Compass Declination 15 1/2  
Firm/Agency: ICE ENGINEERING  
Address:

Party Chief: J. LEONARD  
Notes:  
Witness: N. Fromdahl

Surveyor's Seal

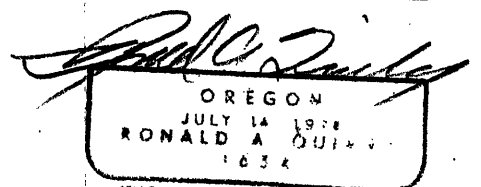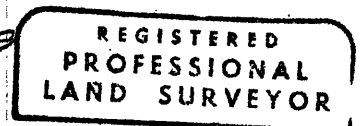

C.S. File EXP 12-31-14

CS 65/82-29