

FILED

Date: 5-1-2014 By: JC
This survey consists of:

CORNER REPORT FORM

Section 13/14 Township 21S Range 8W
Douglas County Date 4/30/2014
PLSS Number 600440

Map: _____
Narrative: _____
Corner Rpt. CS 65/82-33

DOUGLAS COUNTY
SURVEYOR

CORNER DESIGNATION

1/4 corner to 13 and 14

- ___ Condition Report only
- ___ Not Found
- X Renewed
- ___ Unrecorded
- ___ Surveyed In
- ___ Referenced out


Previous Renewals/Surveys, etc:

G.L.O. original survey 1883.
B.L.M. resurvey 1954 (proportioned)

Monument(s) & Accessories Found: (Condition and Source)

1954 B.L.M. brass cap.
Fir stump S.68°45'W., 204.6'
other 1954 B.T. gone.

Monument Detail

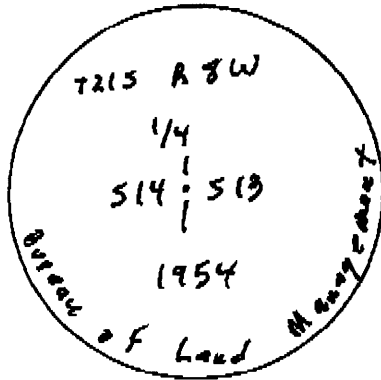

Sketch

Monument Set (Procedures and Description)

N/A

New Accessories

No trees large enough to scribe in Section 14.
An 8" diam. Fir scribed "T21S R8W S13 BT" bears N.80°E., 9.1 feet.
A 15" diam. Fir scribed "T21S R8W S13 BT" bears S.24°E., 14.1 feet.
A 6 foot steel post is set 2 feet North

Surveyor's Seal

Location & Comments

Compass Declination 15 10/2 East
Firm/Agency: David Edwards Land Surveying
Address: P.O. Box 361
Oakland, Oregon 97462
Party Chief: Brant Miller
Notes: same
Witness: Eric Sprinkle

REGISTERED
PROFESSIONAL
LAND SURVEYOR

David A. Edwards

OREGON
JULY 26, 1988
DAVID A. EDWARDS
2339

Renews 12/31/15

C.S. File 65/82-33

600440