

CORNER REPORT FORM

FILED

Section 24 Township 30S Range 8W  
Douglas County Date 4-2014  
PLSS Number 700340

Date: 5/7/2014 By: SC  
This survey consists of:  
Map: \_\_\_\_\_

Narrative: \_\_\_\_\_  
Corner Rpt: CS 65/82-36

DOUGLAS COUNTY  
SURVEYOR

CORNER DESIGNATION

1/4 COR 24/19

- Condition report only
- Not Found
- Renewed
- Unrecorded
- Surveyed In
- Referenced out

Previous Renewals/Surveys, etc:

Johnston 1962 CS 51/163  
BLM Resurvey 1972

Monument(s) & Accessories Found: (Condition and Source)

Fd 55" FIR SWAG COR TREE  
1 1/4" I.P ON WEST SIDE  
2 1/2" BRASS CAP REF. MON N45E 132 FT  
24" FIR S70E 41 1/2 FT GOOD SCAR  
26" FIR N65W 66' x VIS.

Monument Detail

Sketch

Monument Set (Procedures and Description)

New Accessories


Surveyor's Seal

Location & Comments

CORNER IS APPROX  
250' WEST OF RD.  
ON WEST SLOPE

Compass Declination 15 1/2  
Firm/Agency: IENG.  
Address:

Party Chief: J. LEONARD  
Notes:  
Witness: N. FROSTDAHL

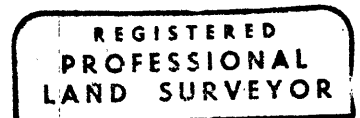

*[Signature]*  
OREGON  
JULY 14 1979  
DONALD A. QUINN

C.S. File 65/82-36