

CORNER REPORT FORM

FILED

Section 24 Township 30S Range 8W
Douglas County Date 5-2014
PLSS Number 600340

Date: 5/27/2014 By: SC
This survey consists of:
Map: _____
Narrative: _____
Corner Rpt: CS 65/82-39

DOUGLAS COUNTY
SURVEYOR

CORNER DESIGNATION

1/4 COR 23/24

- Condition report only
- Not Found
- Renewed
- Unrecorded
- Surveyed In
- Referenced out

Previous Renewals/Surveys, etc:

Johnstone 1962 CS 51/163

Monument(s) & Accessories Found: (Condition and Source)

1" I. PIPE
11" CHINOPINE S23E 30 1/2 FT Vis Scribes
24" D FIR S45W 92 FT GOOD SCAR
30" D FIR N13W 28 1/2 FT GOOD SCAR

Monument Detail

Sketch

Monument Set (Procedures and Description)

New Accessories



A 20" D FIR N73E 16 1/2 FT Scribed 1/4 S 24 BT

Surveyor's Seal

Location & Comments

Compass Declination 15 1/2
Firm/Agency: IE ENG.
Address: _____

Party Chief: J. LEONARD
Notes: _____
Witness: N. Fromm

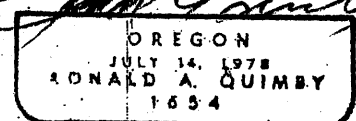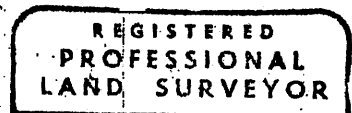

C.S. File 65/82-39