

CORNER REPORT FORM

FILED

Section 24 Township 30S Range 8W
Douglas County Date 5/2014
PLSS Number 600400

Date: 5/27/2014 By: X
This survey consists of:
Map: _____
Narrative: _____
Corner Rpt: CS 65/82-40
DOUGLAS COUNTY
SURVEYOR

CORNER DESIGNATION

See COR. 14/13
23/24

- Condition report only
- Not Found
- Renewed
- Unrecorded
- Surveyed In
- Referenced out

Previous Renewals/Surveys, etc:


Johnstone 1962 CS 51/163
LANG M 150-3 & CS 65/58-2A 2006
BLM Resurvey 2006

Monument(s) & Accessories Found: (Condition and Source)

BLM BRASS CAP
11" LIME OAK SWAG N38E 8.1 FT Healed SCAR
9" D. FIR NBZE 10.18 FT Vis Scribe
18" Cedar SW 30.5 FT " "
24" FIR SW 51.5 Healed SCAR
14" FIR (SWAG) N43W 8.1 FT " "
18" FIR N20W 72.5 FT Vis Scribe

Monument Detail

Sketch

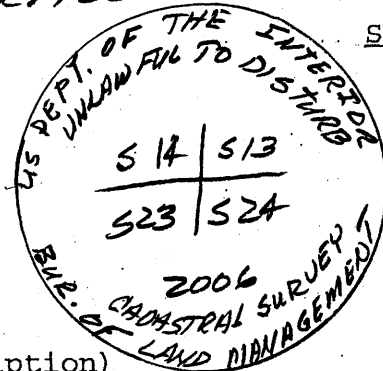

Monument Set (Procedures and Description)

New Accessories

Location & Comments

COR IS ON A westerly
Slope approx 150' west
of Ridge top and
50' ± EAST of SKID
ROAD

Compass Declination 15 1/2
Firm/Agency: IE ENG
Address:

Party Chief: J. LEONARD
Notes:
Witness: N. FROMDANK

Surveyor's Seal

REGISTERED
PROFESSIONAL
LAND SURVEYOR

Ronald A. Quimby
OREGON
JULY 14, 1978
RONALD A. QUIMBY
1954

C.S. File 65/82-40