

CORNER REPORT FORM

FILED

Section 14 Township 24S Range 2W  
Douglas County Date 6/2014  
PLSS Number 400400

Date: 6/17/2014 By: JC  
This survey consists of:  
Map: \_\_\_\_\_  
Narrative: \_\_\_\_\_  
Corner Rpt: CS 65/82-43

DOUGLAS COUNTY  
SURVEYOR

CORNER DESIGNATION

Sec. Cor 14/13  
23/24

- Condition report only
- Not Found
- Renewed
- Unrecorded
- Surveyed In
- Referenced out

Previous Renewals/Surveys, etc:

B. SHAWER 1962 CS 51/245

Monument(s) & Accessories Found: (Condition and Source)

FD 1" Iron PIPE  
44" FIR N 19° E 11 1/2 FT GOOD SCAR  
32" FIR N 45° W 23 1/2 FT " "  
46" FIR S 22° W 7 1/2 FT (REL 3 1/2) GOOD SCAR  
Tree is LEAVING BADLY

Monument Detail

Sketch

Monument Set (Procedures and Description)

New Accessories


12" FIR S 17° E 25 3/4 FT Scribed T24S R2W S24 BT

Surveyor's Seal

Location & Comments

Compass Declination 15 1/2  
Firm/Agency: IENG  
Address:

Party Chief: N From [Signature]  
Notes:  
Witness: R. O. [Signature]

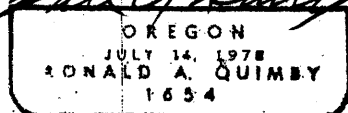

C.S. File 65/82-43