

CORNER REPORT FORM

FILED

Section 14 Township 24S Range 2W
Douglas County Date 6/2014
PLSS Number 600440

Date: 6/17/2014 By: JC
This survey consists of:
Map:
Narrative:
Corner Rpt: CS 65/82-44

DOUGLAS COUNTY
SURVEYOR

CORNER DESIGNATION

1/4 COR 514/513

- Condition report only
- Not Found
- Renewed
- Unrecorded
- Surveyed In
- Referenced out


Previous Renewals/Surveys, etc:

DCSO 1969 CS 54/27

Monument(s) & Accessories Found: (Condition and Source)

DCSO BRASS CAP
16" FIR N75°E 15.5 FT GOOD SCAR
18" FIR S49°E 33 FT GOOD SCAR
27" FIR S12°W 61 FT GOOD SCAR

Monument Detail

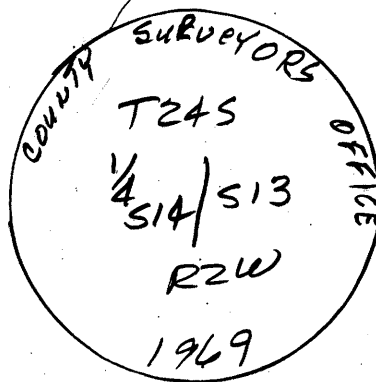

Sketch

Monument Set (Procedures and Description)

New Accessories


10" FIR N48°W 24 FT scribed 1/4 514 BT

Surveyor's Seal

Location & Comments

CORNER IS ON westerly
Slope Approx 300'
West of Road

Compass Declination 15 1/2
Firm/Agency: IEEENG.
Address:
Party Chief: N Fromoshi
Notes:
Witness: R. Olsen

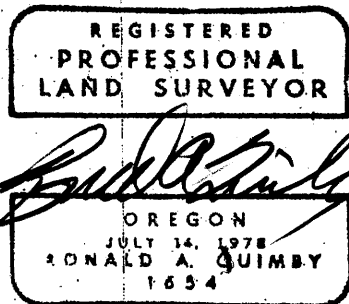

C.S. File 65/82-44