

CORNER REPORT FORM

FILED

Section 14 Township 24S Range 2W
Douglas County Date 6/2014
PLSS Number 600500

Date: 6/17/2014 By: X

This survey consists of:

Map: _____

Narrative: _____

Corner Rpt: CS 65/82-45

DOUGLAS COUNTY
SURVEYOR

CORNER DESIGNATION

See Cor 11/12
14/13

- Condition report only
- Not Found
- Renewed
- Unrecorded
- Surveyed In
- Referenced out


Previous Renewals/Surveys, etc:

DCSO 1969 CS 54/27
BLM Resurvey 1990

Monument(s) & Accessories Found: (Condition and Source)

DCSO BRASS CAP
18" Hemlock N 54 E 29' FT GOOD SCAR
44" FIR N 85° E 21' FT " "
30" FIR SWAG S 33° E 30' FT " "
30" Hemlock N 27° W 30' FT

Monument Detail

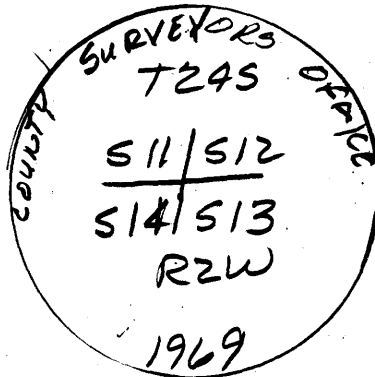

Sketch

Monument Set (Procedures and Description)

New Accessories

30" Hemlock S 12 W 9 3/4 FT Scribed T24S R2W S14 BY


Surveyor's Seal

Location & Comments

CORNER IS IN THE
S.W. CORNER OF OLD
LOGGING APPROX
200' N.W. OF THE
END OF SKID
ROAD

Compass Declination 15 1/2
Firm/Agency: IENG
Address:

Party Chief: Fromdahl
Notes:
Witness: Olson

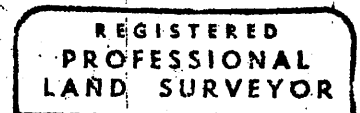

Ronald A. Quimby
OREGON
JULY 14, 1978
RONALD A. QUIMBY
1654

C.S. File 65/82-45