

CORNER REPORT FORM

FILED

Section 16
Douglas County
PLSS Number

Township 32S Range 7W
Date 7-2014

Date: 7/2/2014 By: JC
This survey consists of:
Map:
Narrative:
Corner Rpt: CS 65/82-49

DOUGLAS COUNTY
SURVEYOR

CORNER DESIGNATION

SEC COR: 517/516
520/521

- Condition report only
- Not Found
- Renewed
- Unrecorded
- Surveyed In
- Referenced out


Previous Renewals/Surveys, etc:

DCSO 1967 CS 54/36
BLM 1978
BLM 2002

Monument(s) & Accessories Found: (Condition and Source)

DCSO BRASS CAP
BANKING TREES FOR PLSS 300400
7 Trees Fd.

Monument Detail

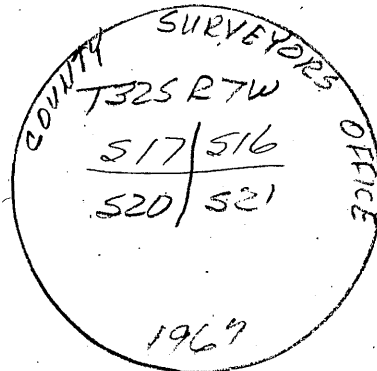

Sketch


Monument Set (Procedures and Description)

New Accessories

Location & Comments

Surveyor's Seal

Compass Declination 15 1/2
Firm/Agency: ICEOG
Address:

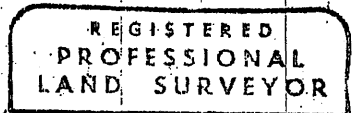

Party Chief: N. Fromholz
Notes:
Witness: R. Olson

Donald A. Quimby
OREGON
JULY 14, 1978
DONALD A. QUIMBY
1654

C.S. File 65/82-49