

CORNER REPORT FORM

FILED

Section 16 Township 32S Range 7W  
Douglas County Date 7/2014  
PLSS Number 300440

Date: 7-2-2014 By: SC

This survey consists of:

Map: \_\_\_\_\_

Narrative: \_\_\_\_\_

Corner Rpt: CS 65/82-51

DOUGLAS COUNTY  
SURVEYOR

CORNER DESIGNATION

1/4 COR 517/516

- Condition report only
- Not Found
- Renewed
- Unrecorded
- Surveyed In
- Referenced out


Previous Renewals/Surveys, etc:

BLM 1978

Monument(s) & Accessories Found: (Condition and Source)

BLM BRASS CAP  
14" FIR N83°E 35' FT GOOD SCAR  
13" FIR S38W 54' FT GOOD SCAR

Monument Detail

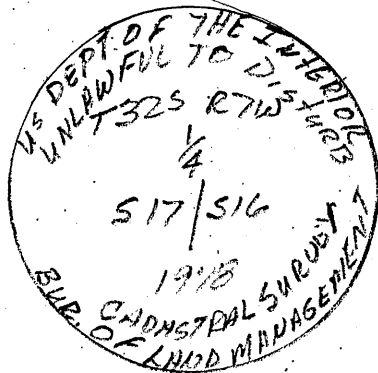

Sketch

Monument Set (Procedures and Description)

New Accessories


34" FIR N35W 40' FT Scribed 1/4 517 BT  
14" FIR S33E 49' FT Scribed 1/4 516 BT

Location & Comments

Compass Declination 15 1/2  
Firm/Agency: ICENG  
Address: \_\_\_\_\_

Party Chief: AFronsdal  
Notes: \_\_\_\_\_  
Witness: Rolsen

Surveyor's Seal

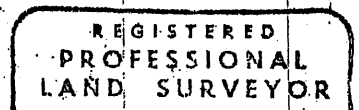

C.S. File 65/82-51