

FILED

Date: 7-8-2014 By: JC

This survey consists of:

Map: \_\_\_\_\_

Narrative: \_\_\_\_\_

Corner Rpt: CS 65/82-54

DOUGLAS COUNTY  
SURVEYOR

CORNER REPORT FORM

Section 14 Township 30S Range 8W  
Douglas County Date 6/26/2014  
PLSS Number 500400

CORNER DESIGNATION

SW Corner Section 14

- \_\_\_ Condition Report only
- \_\_\_ Not Found
- X Renewed
- \_\_\_ Unrecorded
- \_\_\_ Surveyed In
- \_\_\_ Referenced out

Previous Renewals/Surveys, etc:

Orig. GLO W.H. Byars 1882  
B.L.M. resurvey 1964. 1981 D.C.S. renewal

Monument(s) & Accessories Found: (Condition and Source)

1964 B.L.M. Brass Cap.  
22" Fir stump S.22°W., 54.8' 16" capped stump N.81 1/2°E., 148.7' (Fir)  
45" capped Fir stump S.35°E., 15.2' Boat spike in 18" Fir Stump S.49°W., 42.5'  
Boat spike in 36" Fir stump N.24°W., 58.0'

Monument Detail

Sketch

standard B.L.M Brass Cap

Monument Set (Procedures and Description)

N/A

New Accessories


A 5" diam. Fir scribed "T30S R8W S14 BT" bears N.19°E., 8.7 feet.  
A six foot steel post is set 2 feet East

Surveyor's Seal

Location & Comments



*David A. Edwards*

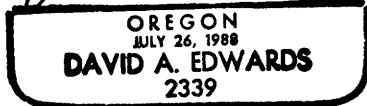

Renews 12/31/15

Compass Declination 15 1/2° East

Firm/Agency: David Edwards Land Surveying

Address: P.O. Box 361  
Oakland, OR. 97462

Party Chief: Brant Miller

Notes: \_\_\_\_\_

Witness: Eric Sprinkle

C.S. File 65/82-54