

FILED JUL 22 2014
T 325 RBW

5/16 SID/S11 500520
FD OK


SEC

S10	S11
S15	S14

 500500
FD OK.

July 2014

REGISTERED
PROFESSIONAL
LAND SURVEYOR

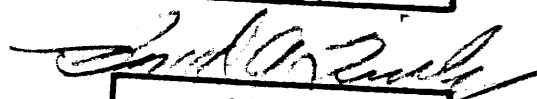

OREGON
JULY 14, 1978
RONALD A. QUIMBY
1934

EXP 12-31-14

C.S. File No 65/82-56