

FILED

Date: 7/22/2014 By: SC

This survey consists of:

Map: \_\_\_\_\_

Narrative: \_\_\_\_\_

Corner Rpt: C565/8259

DOUGLAS COUNTY  
SURVEYOR

CORNER REPORT FORM

Section 2 Township 25S Range 2W  
Douglas County Date 7-21-14  
PLSS Number 600700

CORNER DESIGNATION

NE Corner Section 2

- \_\_\_ Condition Report only
- \_\_\_ Not Found
- X Renewed
- \_\_\_ Unrecorded
- \_\_\_ Surveyed In
- \_\_\_ Referenced out

Previous Renewals/Surveys, etc:

Orig. 1883 by McQuinn  
BLM resurvey 1951-1963 by Tallett and White

Monument(s) & Accessories Found: (Condition and Source)

1951 BLM brass cap  
35" diam. Fir snag bears N.56°E., 121.4 feet w/healed blaze  
44' diam. Pine stump bears S.28°E., 18.5 feet.  
42" diam. Pine stump bears S.23½°W., 30.4 feet.  
The fir N.83¼°W., 41.6 feet is gone.

Monument Detail

Sketch

Standard BLM brass capped  
iron pipe.

Monument Set (Procedures and Description)



N/A

New Accessories

A 10" diam. Fir scribed "T25S R2W S1 BT" bears S.42°E., 4.45 feet.  
A 6" diam. Fir scribed "T25S R2W S2 BT" bears S.60°W., 14.45 feet.  
6 foot steel posts are set N.22E., 2 feet and S. 6½°E., 2 feet.  
Surveyor's Seal

Location & Comments

Compass Declination 15½° E.  
Firm/Agency: David Edwards Land Surveying  
Address: P.O. Box 361  
Oaklnad, OR. 97462  
Party Chief: Brant Miller  
Notes: \_\_\_\_\_  
Witness: Eric Sprinkle

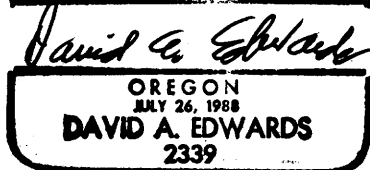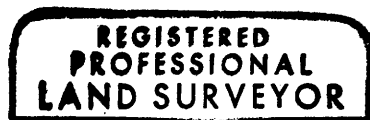

Renews 12/31/15

C.S. File 65/82-59