


RECORD OF SURVEY  
 FOR: SENECA JONES TIMBER COMPANY  
 NW1/4, SECTION 12, T.22 S., R.8 W., W.M.  
 DOUGLAS COUNTY, OREGON  
 18 JULY 2014



FILED  
 DATE: 8-7-2014 BY: JC  
 THIS SURVEY CONSISTS OF:  
 MAP: CS 65/84-8  
 NARRATIVE:  
 CORNER RPT:  
 DOUGLAS COUNTY  
 SURVEYOR

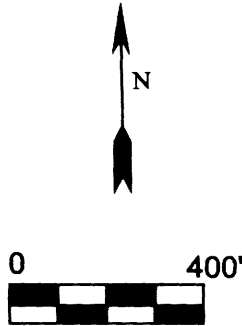


SECTION CORNER SECTIONS 1,2,11,12  
 FOUND BLM BRASS CAP DATED 1967  
 WITH THE FOLLOWING ACCESSORIES:  
 23" D. FIR BEARS N 19° E 40.9' - HEALED FACE  
 19" D. FIR BEARS S 16° E 90.8' - HEALED FACE  
 16" D. FIR BEARS S 43-3/4° W 14.2' - HEALED FACE  
 21" D. FIR BEARS N 25-3/4° W 23.5' - HEALED FACE  
 OTHER ACCESSORIES OF RECORD NOT SEARCHED FOR  
 STEEL POST ADJACENT TO CORNER

1/4 CORNER SECTIONS 1,12  
 FOUND INTERNATIONAL PAPER CO. ALUMINUM CAP  
 DATED 1985 WITH THE FOLLOWING ACCESSORIES:  
 35" HEMLOCK BEARS N 32° E 58.1' - HEALED FACE  
 17" HEMLOCK BEARS S 83° E 9.5' - HEALED FACE  
 OTHER ACCESSORIES OF RECORD NOT SEARCHED FOR  
 STEEL POST ADJACENT TO CORNER

LEGEND

-  SET 1/4 CORNER AS NOTED
-  SECTION CORNER AS NOTED
- [ ] 1881 GENERAL LAND OFFICE RECORD DATA
- BLM BUREAU OF LAND MANAGEMENT

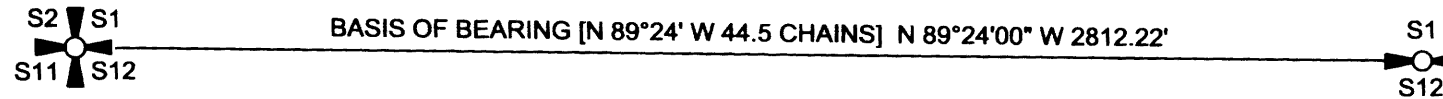

NARRATIVE:

THE PURPOSE OF THIS SURVEY WAS TO MARK TRUE LINE BETWEEN THE NORTHWEST CORNER AND NORTH 1/4 CORNER OF SECTION 12 TOWNSHIP 22 SOUTH, RANGE 8 WEST OF THE WILLAMETTE MERIDIAN.

EXISTING CORNERS WERE TIED BY TRAVERSE AND HELD IN THEIR AS-TIED POSITION FOR THE MARKING OF TRUE LINE.


TRUE LINE WAS MARKED WITH RED PAINTED BLAZES, RED FLAGGING, AND 5-1/2' GALVANIZED STEEL POSTS, SET AND AVERAGE INTERVAL OF 200'.

THE BASIS OF BEARING FOR THIS SURVEY WAS THE 1881 GENERAL LAND OFFICE RECORD FOR THE ABOVE REFERENCED LINE.

THIS SURVEY WAS PERFORMED USING A NIKON TOTAL STATION.

REGISTERED  
 PROFESSIONAL  
 LAND SURVEYOR  
*Ronald L. Rice*  
 OREGON  
 JULY 9, 2002  
 RONALD L. RICE  
 54633LS

EXPIRATION DATE: 12-31-2014

 Northwest Land Surveying, Inc.  
 P. O. Box 2827  
 FLORENCE, OR 97439 541-997-9201

FILE NAME		
14-61		
SCALE	DATE	DRAWN BY
400 Ft/in	7-18-2014	RLR
JOB	REVISION	SHEET
W. PARADISE	—	1/1

This map drawn with TRAVERSE PC Software

C.S. File No 65/84-8