


USDA-FOREST SERVICE

Index

CORNER RECORD (SEARCH)

File No. R-7 PROJ. NO. ELK CORNER 1/4  
 TOWNS. 31 S RANGE 1 W R.D. TILLER COUNTY DOUGLAS GCDB# 240300  
 MERID. WM FOREST UMPQUA STATE OREGON

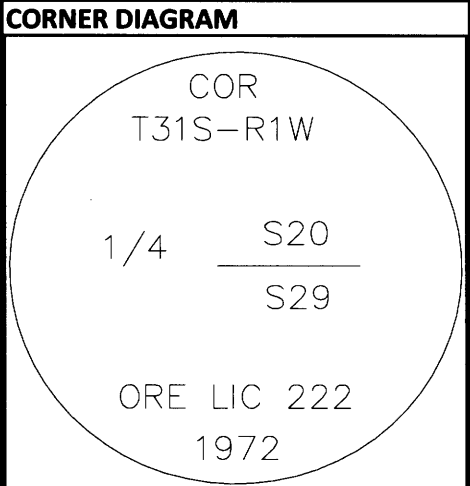

**DESCRIBE CORNER MONUMENT FOUND**  
 FOUND 3" BRASS CAP ON 2-1/2" IRON PIPE, FLUSH IN A MOUND OF STONE.

**DESCRIBE BEARING TREES OR OTHER OFFICIAL ACCESSORIES FOUND**

DIA	TYPE	BEARS	DIST	FACE/MARKINGS
20"	P.PINE	(N17°15'W)	(40.0 FT)	HEALED DOUBLE BLAZE
19"	D.FIR	(S6°30'E)	(24.8 FT)	HEALED DOUBLE BLAZE
5"	OAK	(N52°W)	(14.5 FT)	RECORD IS OAK SHOOTS, AT RECORD DISTANCE IS BURL OF A YOUNG OAK

( ) = RECORD PER M42-70

Obj. Ident. \_\_\_\_\_  
 Ident. By \_\_\_\_\_  
 Signature \_\_\_\_\_

**DESCRIBE CORNER LOCATION RELATIVE TO NEAR-BY FEATURES, ALSO HOW TO REACH CORNER**  
 CORNER FALLS ON NEARLY LEVEL GROUND, ABOUT 300 FT NE FROM A SWITCHBACK ON FS ROAD 1610-300. E-W FENCELINE ABOUT 10 FT NORTH

**PLANE COORDINATE POSITION DATA**  
 State \_\_\_\_\_ Zone \_\_\_\_\_  
 North \_\_\_\_\_  
 West \_\_\_\_\_  
 Estab. By \_\_\_\_\_

Signature \_\_\_\_\_ Title \_\_\_\_\_ Division \_\_\_\_\_ Headquarters \_\_\_\_\_ Date 7100-52 (3/68)

CORNER RECORD (PERPETUATION)

**REGISTERED PROFESSIONAL LAND SURVEYOR**  
*John Ransom*  
**OREGON**  
 JULY 21, 1982  
**JOHN C. RANSOM**  
 2561

**MONUMENT : DESCRIBE NEW MONUMENT SET, OR WORK DONE TO PRESERVE EXISTING MONUMENT**

BRUSH CLEARED AROUND MONUMENT AND TO BT'S  
 "LAND LINE" FLAGGING TIED ON MONUMENT AND GUARD POSTS

**ACCESSORIES : DESCRIBE NEW BT's WITNESS OBJECTS ETC. ESTABLISHED, OR WORK DONE TO PRESERVE EXISTING EVIDENCE**

NO NEW ACCESSORIES ADDED  
 NEW NAILS IN BT TAGS AND PAINTED FACES & 6 INCH BAND AT HEAD HEIGHT

DONE BY: Jonathan Drew TITLE LSIT DATE 1/15/2014 PLS NO./AGENCY/STATE JOHN RANSOM, PLS2561  
 Certified Cor. Record Prepared? NO Filed At: \_\_\_\_\_ DATE \_\_\_\_\_

**REMARKS**  
 PROPERTY LINE MAINTINED EAST .25 AND WEST .25 MILES

Index File No R-7 T. 31 S R. 1 W M. WM Proj No. ELK Cor. 1/4

C.S. File No 65/85-4