


FILED JUL 2 2014

USDA-FOREST SERVICE

Index

CORNER RECORD (SEARCH)

File No. W-8.25 PROJ. NO. ELK CORNER 1/256 WC
TOWNS. 31 S RANGE 1 W R.D. TILLER COUNTY DOUGLAS GCDB# 265160
MERID. WM FOREST UMPQUA STATE OREGON

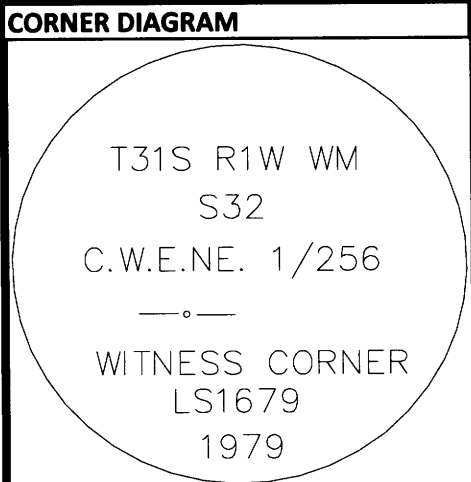

DESCRIBE CORNER MONUMENT FOUND
FOUND 2-1/2" BRASS CAP ON 2-1/4" IRON PIPE, PROJECTING 5 INCHES ABOVE THE GROUND.

DESCRIBE BEARING TREES OR OTHER OFFICIAL ACCESSORIES FOUND
DIA TYPE BEARS DIST FACE/MARKINGS
17" FIR (S23°04'E) (12.5 FT) HEALED DOUBLE BLAZE
20" CEDAR (N41°56'E) (18.5 FT) HEALED DOUBLE BLAZE
(5/8") (REBAR & CAP) (EAST) (3.0 FT) SEARCHED FOR AND NOT FOUND, USE TAPE RECORD BEARING/DISTANCE AND FALL IN STUMP ROOT NO MAGNETIC DETECTOR ON HAND, AREA NOT DISTURBED, REBAR ASSUMED TO EXIST, PERHAPS UNDER ROOT.
() = RECORD PER 1992 CORNER CARD BY K.O. DEGROOT

Obj. Ident.
Ident. By
Signature

DESCRIBE CORNER LOCATION RELATIVE TO NEAR-BY FEATURES, ALSO HOW TO REACH CORNER
WITNESS CORNER FALLS NEAR EDGE OF A PRIVATE ROAD. TO ACCESS TAKE COUNTY ROAD 1A 3/4 MILE TO PULL OUT JUST PAST BRIDGE, ON EAST SIDE OF ROAD IS A PRIVATE ROAD AND A LOCKED GATE, CROSS FENCE ON FOOT AND WALK ROAD 1000 FEET TO CORNER, FALLS SOUTH OF ROAD

PLANE COORDINATE POSITION DATA
State Zone
North
West
Estab. By

Signature Title Division Headquarters Date 7100-52 (3/68)

CORNER RECORD (PERPETUATION)

REGISTERED PROFESSIONAL LAND SURVEYOR

John Ransom

OREGON JULY 21, 1922 JOHN C. RANSOM 2561

MONUMENT : DESCRIBE NEW MONUMENT SET, OR WORK DONE TO PRESERVE EXISTING MONUMENT
BRUSH CLEARED AROUND MONUMENT AND TO BT'S
"LAND LINE" FLAGGING TIED ON MONUMENT AND GUARD POSTS

ACCESSORIES : DESCRIBE NEW BT's WITNESS OBJECTS ETC. ESTABLISHED, OR WORK DONE TO PRESERVE EXISTING EVIDENCE
NO NEW ACCESSORIES ADDED
NEW NAILS IN BT TAGS AND PAINTED FACES & 6 INCH BAND AT HEAD HEIGHT

DONE BY: Jonathan Drew TITLE LSIT DATE 12/19/2014 PLS NO./AGENCY/STATE JOHN RANSOM, PLS2561
Certified Cor. Record Prepared? NO Filed At: DATE

REMARKS
PROPERTY LINE MAINTINED NORTH 660 FT +/- ON THIS DATE

Index File No W-8.25 T. 31 S R. 1 W M. WM Proj No. ELK Cor. 1/256 WC

C.S. File No 65/85-7