


Index

CORNER RECORD (SEARCH)

File No. V-8.5 PROJ. NO. ELK CORNER EE 1/64
TOWNS. 31 S RANGE 1 W R.D. TILLER COUNTY DOUGLAS GCDB# 270200
MERID. WM FOREST UMPQUA STATE OREGON

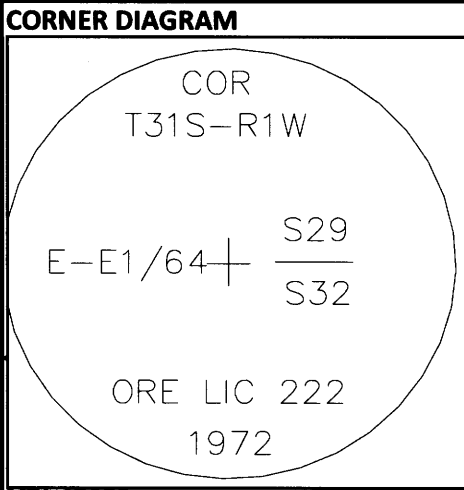

DESCRIBE CORNER MONUMENT FOUND
FOUND 3" BRASS CAP ON 2-1/2" IRON PIPE, FLUSH IN A MOUND OF STONE

DESCRIBE BEARING TREES OR OTHER OFFICIAL ACCESSORIES FOUND
DIA TYPE BEARS DIST FACE/MARKINGS
18" D.FIR (N29°50'E) (49.0 FT) HEALED DOUBLE BLAZE
22" D.FIR (S16°06'W) (80.4 FT) HEALED DOUBLE BLAZE
NE BT HAS HAD TOP REMOVED BY POWERLINE COMPANY IS NOW 25' TALL AND ALIVE
( ) = RECORD PER M81-58

Obj. Ident.
Ident. By
Signature

PLANE COORDINATE POSITION DATA
State Zone
North
West
Estab. By

DESCRIBE CORNER LOCATION RELATIVE TO NEAR-BY FEATURES, ALSO HOW TO REACH CORNER
CORNER FALLS IN FENCELINE INSIDE POWERLINE CORRIDOR, FENCE CROSSES POWERLINE E-W AND POWERLINE BEARS N/NE-S/SW. BT'S FALL ON EDGE OF POWERLINE CORRIDOR. TO ACCESS LINE TAKE COUNTY ROAD 1-A TO PULL-OUT JUST PAST BRIDGE, ON NORTH SIDE OF ROAD FOLLOW GATED ROAD TO POWERLINE, FOLLOW ROUGH POWERLINE ROAD TO CORNER.

Signature Title Division Headquarters Date 7100-52 (3/68)

CORNER RECORD (PERPETUATION)

MONUMENT : DESCRIBE NEW MONUMENT SET, OR WORK DONE TO PRESERVE EXISTING MONUMENT

BRUSH CLEARED AROUND MONUMENT AND TO BT'S
"LAND LINE" FLAGGING TIED ON MONUMENT AND GUARD POSTS

REGISTERED PROFESSIONAL LAND SURVEYOR
John Ransom
OREGON JULY 21, 1992 JOHN C. RANSOM 2661

ACCESSORIES : DESCRIBE NEW BT'S WITNESS OBJECTS ETC. ESTABLISHED, OR WORK DONE TO PRESERVE EXISTING EVIDENCE

NO NEW ACCESSORIES ADDED
NEW NAILS IN BT TAGS AND PAINTED FACES & 6 INCH BAND AT HEAD HEIGHT

DONE BY: Jonathan Drew TITLE LSIT DATE 11/25/2013 PLS NO./AGENCY/STATE JOHN RANSOM, PLS2561
Certified Cor. Record Prepared? NO Filed At: DATE

REMARKS
PROPERTY LINE MAINTINED SOUTH 660'+/- AND EAST TO SECTION CORNER

Index File No V-8.5 T. 31 S R. 1 W M. WM Proj No. ELK Cor. EE 1/64

C.S. File No 65/85-8