


Index **CORNER RECORD (SEARCH)**  
 File No. U-9 PROJ. NO. ELK CORNER S 1/16  
 TOWNS. 31 S RANGE 1 W R.D. TILLER COUNTY DOUGLAS GCDB# 300220  
 MERID. W.M. FOREST UMPQUA STATE OREGON

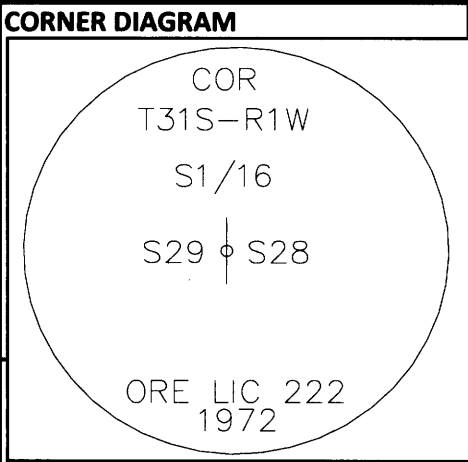

**DESCRIBE CORNER MONUMENT FOUND**  
 FOUND 3" BRASS CAP ON 2-1/2" IRON PIPE, PROJECTING 3 INCHES ABOVE A LARGE MOUND OF STONE.

**DESCRIBE BEARING TREES OR OTHER OFFICIAL ACCESSORIES FOUND**

DIA	TYPE	BEARS	DIST	FACE/MARKINGS
15"	FIR	S32°E	18.1 FT	HEALED DOUBLE BLAZE
12"	FIR	N81°30'W	7.1 FT	HEALED DOUBLE BLAZE

Obj. Ident. \_\_\_\_\_  
 Ident. By \_\_\_\_\_  
 Signature \_\_\_\_\_

**DESCRIBE CORNER LOCATION RELATIVE TO NEAR-BY FEATURES, ALSO HOW TO REACH CORNER**  
 CORNER FALLS ON SOUTH SLOPE, NORTH OF FENCE CORNER, FOLLOW NOTES FOR CORNER V-9 , THEN FOLLOW FENCELINE/POSTED LINE NORTH 1/4 MILE.

**PLANE COORDINATE POSITION DATA**  
 State \_\_\_\_\_ Zone \_\_\_\_\_  
 North \_\_\_\_\_  
 West \_\_\_\_\_  
 Estab. By \_\_\_\_\_

Signature \_\_\_\_\_ Title \_\_\_\_\_ Division \_\_\_\_\_ Headquarters \_\_\_\_\_

**CORNER RECORD (PERPETUATION)**

**MONUMENT : DESCRIBE NEW MONUMENT SET, OR WORK DONE TO PRESERVE EXISTING MONUMENT**  
 BRUSH CLEARED AROUND MONUMENT AND TO BT'S  
 "LAND LINE" FLAGGING TIED ON MONUMENT AND GUARD POSTS

REGISTERED PROFESSIONAL LAND SURVEYOR  
*John Ransom*  
 OREGON JULY 21, 1992  
 JOHN C. RANSOM  
 2561

**ACCESSORIES : DESCRIBE NEW BT's WITNESS OBJECTS ETC. ESTABLISHED, OR WORK DONE TO PRESERVE EXISTING EVIDENCE**  
 RED PAINT APPLIED TO BT FACES AND A 6" BAND AT HEAD HEIGHT, BT'S INCLUDE BT & SURVEY MONUMENT TAGS

DONE BY: Jonathan Drew TITLE LSIT DATE 1/16/2014 PLS NO./AGENCY/STATE \_\_\_\_\_  
 Certified Cor. Record Prepared? YES Filed At: DOUGLAS CO. DATE \_\_\_\_\_

**REMARKS**  
 MEASURMENTS TO ACCESSORIES MADE WITH A LEICA 1103+ TOTAL STATION WITH REFLECTORLESS EDM TO ALUMINUM NAIL SET AT SIDE CENTER, BASIS OF BEARING FROM M81-59, BEING N00°13'59"E FROM AN OPEN TRAVERSE RUN BETWEEN THIS CORNER AND THE SECTION CORNER TO THE SOUTH.  
 MAINTAINED PROPERTY LINE SOUTH .25 AND EAST .25 MILES

Index File No U-9 T. 31 S R. 1 W M. W.M. Proj No. ELK Cor. S 1/16