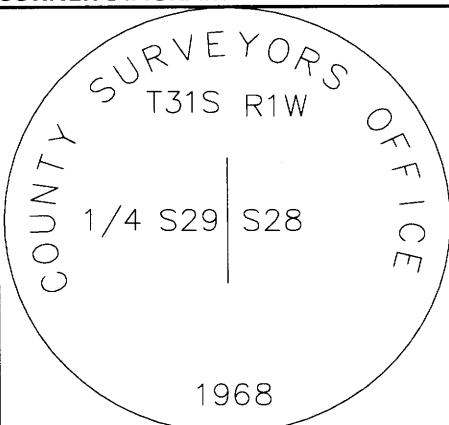


Index

CORNER RECORD (SEARCH)

File No. T-9 PROJ. NO. ELK CORNER 1/4  
 TOWNS. 31 S RANGE 1 W R.D. TILLER COUNTY DOUGLAS GCDB# 300240  
 MERID. WM FOREST UMPQUA STATE OREGON

<b>CORNER DIAGRAM</b> 	<b>DESCRIBE CORNER MONUMENT FOUND</b> FOUND 2-1/2" BRASS CAP ON 1-1/4" IRON PIPE, PROJECTING 5 INCHES ABOVE A MOUND OF STONE.																									
Obj. Ident. _____ Ident. By _____ Signature _____	<b>DESCRIBE BEARING TREES OR OTHER OFFICIAL ACCESSORIES FOUND</b> <table border="1"> <thead> <tr> <th>DIA</th> <th>TYPE</th> <th>BEARS</th> <th>DIST</th> <th>FACE/MARKINGS</th> </tr> </thead> <tbody> <tr> <td>INDT</td> <td>PINE STOB</td> <td>(S89°E)</td> <td>(20.5 FT)</td> <td>ROTTEN REMAINS OF STOB, NO FACE</td> </tr> <tr> <td>7"</td> <td>W.OAK</td> <td>(N25°W)</td> <td>(51.8 FT)</td> <td>HEALED DOUBLE BLAZE</td> </tr> <tr> <td>23"</td> <td>P.PINE</td> <td>(S21°30'W)</td> <td>(37.6 FT)</td> <td>HEALED SINGLE BLAZE</td> </tr> <tr> <td>13"</td> <td>W.OAK</td> <td>(S26°E)</td> <td>(10.6 FT)</td> <td>HEALED SINGLE BLAZE</td> </tr> </tbody> </table> <p>( ) = RECORD PER 63/138</p>	DIA	TYPE	BEARS	DIST	FACE/MARKINGS	INDT	PINE STOB	(S89°E)	(20.5 FT)	ROTTEN REMAINS OF STOB, NO FACE	7"	W.OAK	(N25°W)	(51.8 FT)	HEALED DOUBLE BLAZE	23"	P.PINE	(S21°30'W)	(37.6 FT)	HEALED SINGLE BLAZE	13"	W.OAK	(S26°E)	(10.6 FT)	HEALED SINGLE BLAZE
DIA	TYPE	BEARS	DIST	FACE/MARKINGS																						
INDT	PINE STOB	(S89°E)	(20.5 FT)	ROTTEN REMAINS OF STOB, NO FACE																						
7"	W.OAK	(N25°W)	(51.8 FT)	HEALED DOUBLE BLAZE																						
23"	P.PINE	(S21°30'W)	(37.6 FT)	HEALED SINGLE BLAZE																						
13"	W.OAK	(S26°E)	(10.6 FT)	HEALED SINGLE BLAZE																						
<b>PLANE COORDINATE POSITION DATA</b> State _____ Zone _____ North _____ West _____ Estab. By _____ Signature _____	<b>DESCRIBE CORNER LOCATION RELATIVE TO NEAR-BY FEATURES, ALSO HOW TO REACH CORNER</b> CORNER FALLS ON NEARLY LEVEL GROUND, ABOUT 40 FEET EASTERLY OF FS ROAD 1610-370, ALSO FALLS AT THE SW CORNER OF A PRIVATE CLEAR CUT UNIT, FROM INTERSECTION OF 300 AND 370 SPUR DRIVE SOUTH 1/4 MILE TO CORNER.																									

Signature \_\_\_\_\_ Title \_\_\_\_\_ Division \_\_\_\_\_ Headquarters \_\_\_\_\_ Date 7100-52 (3/68)

CORNER RECORD (PERPETUATION)

**MONUMENT : DESCRIBE NEW MONUMENT SET, OR WORK DONE TO PRESERVE EXISTING MONUMENT**

BRUSH CLEARED AROUND MONUMENT AND TO BT'S  
 "LAND LINE" FLAGGING TIED ON MONUMENT AND GUARD POSTS

**REGISTERED PROFESSIONAL LAND SURVEYOR**

*John Ransom*

**OREGON**  
 JULY 21, 1902  
**JOHN C. RANSOM**  
 2561

**ACCESSORIES : DESCRIBE NEW BT's WITNESS OBJECTS ETC. ESTABLISHED, OR WORK DONE TO PRESERVE EXISTING EVIDENCE**

NO NEW ACCESSORIES ADDED  
 NEW NAILS IN BT TAGS AND PAINTED FACES & 6 INCH BAND AT HEAD HEIGHT

DONE BY: Jonathan Drew TITLE LSIT DATE 1/6/2014 PLS NO./AGENCY/STATE JOHN RANSOM, PLS2561  
 Certified Cor. Record Prepared? NO Filed At: \_\_\_\_\_ DATE \_\_\_\_\_

**REMARKS**

PROPERTY LINE MAINTINED EAST .25 AND NORTH .25 MILES

Index File No T-9 T. 31 S R. 1 W M. WM Proj No. ELK Cor. 1/4

C.S. File No 65/85-11