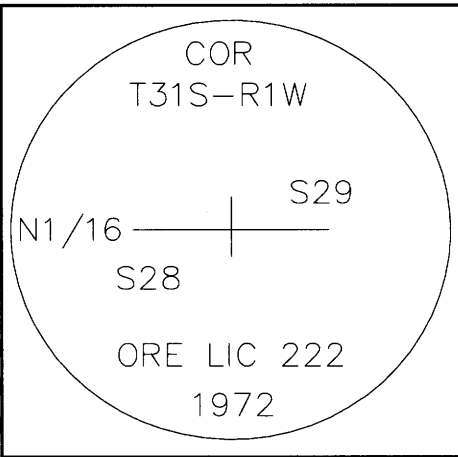


Index

CORNER RECORD (SEARCH)

File No. S-9 PROJ. NO. ELK CORNER N1/16
 TOWNS. 31 S RANGE 1 W R.D. TILLER COUNTY DOUGLAS GCDB# 300260
 MERID. WM FOREST UMPQUA STATE OREGON

<p>CORNER DIAGRAM</p>  <p>Obj. Ident. _____ Ident. By _____ Signature _____</p> <p>PLANE COORDINATE POSITION DATA</p> <p>State _____ Zone _____ North _____ West _____ Estab. By _____</p>	<p>DESCRIBE CORNER MONUMENT FOUND</p> <p>FOUND 3" BRASS CAP ON 2-1/2" IRON PIPE, PROJECTING 2 INCHES IN A MOUND OF STONE.</p> <hr/> <p>DESCRIBE BEARING TREES OR OTHER OFFICIAL ACCESSORIES FOUND</p> <table border="1" style="width:100%; border-collapse: collapse;"> <thead> <tr> <th>DIA</th> <th>TYPE</th> <th>BEARS</th> <th>DIST</th> <th>FACE/MARKINGS</th> </tr> </thead> <tbody> <tr> <td>14"</td> <td>OAK</td> <td>(N3°30'E)</td> <td>(34.0 FT)</td> <td>HEALED DOUBLE BLAZE</td> </tr> <tr> <td>16"</td> <td>OAK</td> <td>(S75°30'W)</td> <td>(35.5 FT)</td> <td>HEALED DOUBLE BLAZE</td> </tr> </tbody> </table> <p style="text-align: right;">() = RECORD PER M42-70</p> <hr/> <p>DESCRIBE CORNER LOCATION RELATIVE TO NEAR-BY FEATURES, ALSO HOW TO REACH CORNER</p> <p>CORNER FALLS EAST 150 FT +/- FROM PROPERTY LINE CROSSING WITH FS ROAD 1610-300, TAKE 300 ROAD FROM HIGHWAY, GO PAST THE 1610-370 ROAD INTERSECTION TO THE NEXT LINE CROSSING, FOLLOW POSTED LINE EAST TO CORNER</p>	DIA	TYPE	BEARS	DIST	FACE/MARKINGS	14"	OAK	(N3°30'E)	(34.0 FT)	HEALED DOUBLE BLAZE	16"	OAK	(S75°30'W)	(35.5 FT)	HEALED DOUBLE BLAZE
DIA	TYPE	BEARS	DIST	FACE/MARKINGS												
14"	OAK	(N3°30'E)	(34.0 FT)	HEALED DOUBLE BLAZE												
16"	OAK	(S75°30'W)	(35.5 FT)	HEALED DOUBLE BLAZE												

Signature _____ Title _____ Division _____ Headquarters _____ Date 7100-52 (3/68)

CORNER RECORD (PERPETUATION)

REGISTERED
PROFESSIONAL
LAND SURVEYOR

John Ransom

OREGON
JULY 21, 1992
JOHN C. RANSOM
2561

MONUMENT : DESCRIBE NEW MONUMENT SET, OR WORK DONE TO PRESERVE EXISTING MONUMENT

BRUSH CLEARED AROUND MONUMENT AND TO BT'S
 "LAND LINE" FLAGGING TIED ON MONUMENT AND GUARD POSTS
 NOTE: SECTION NUMBERS ON FOUND CAP APPEAR TO BE REVERSED.

ACCESSORIES : DESCRIBE NEW BT'S WITNESS OBJECTS ETC. ESTABLISHED, OR WORK DONE TO PRESERVE EXISTING EVIDENCE

NO NEW ACCESSORIES ADDED
 NEW NAILS IN BT TAGS AND PAINTED FACES & 6 INCH BAND AT HEAD HEIGHT

DONE BY: Jonathan Drew TITLE LSIT DATE 1/6/2014 PLS NO./AGENCY/STATE JOHN RANSOM, PLS2561
 Certified Cor. Record Prepared? NO Filed At: _____ DATE _____

REMARKS

PROPERTY LINE MAINTINED WEST .25 AND SOUTH .25 MILES

Index File No S-9 T: 31 S R. 1 W M. WM Proj No. ELK Cor. N1/16

C.S. File No 45/85-12