


Index

CORNER RECORD (SEARCH)

File No. T-11 PROJ. NO. ELK CORNER C 1/4  
 TOWNS. 31 S RANGE 1 W R.D. TILLER COUNTY DOUGLAS GCDB# 340240  
 MERID. WM FOREST UMPQUA STATE OREGON

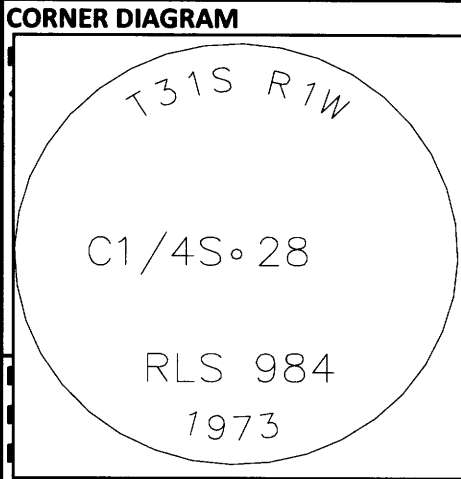

DESCRIBE CORNER MONUMENT FOUND  
 FOUND 3" BRASS CAP ON 2-1/2" IRON PIPE, PROJECTING 6 INCHES ABOVE A MOUND OF STONE.

DESCRIBE BEARING TREES OR OTHER OFFICIAL ACCESSORIES FOUND

DIA	TYPE	BEARS	DIST	FACE/MARKINGS
28"	D.FIR	(N73°28'E)	(35.5 FT)	HEALED DOUBLE BLAZE
10"	W.OAK	(S50°40'W)	(35.7 FT)	HEALED DOUBLE BLAZE

( ) = RECORD PER M81-59

Obj. Ident. \_\_\_\_\_  
 Ident. By \_\_\_\_\_  
 Signature \_\_\_\_\_

PLANE COORDINATE POSITION DATA  
 State \_\_\_\_\_ Zone \_\_\_\_\_  
 North \_\_\_\_\_  
 West \_\_\_\_\_  
 Estab. By \_\_\_\_\_

DESCRIBE CORNER LOCATION RELATIVE TO NEAR-BY FEATURES, ALSO HOW TO REACH CORNER  
 CORNER FALLS ON SOUTH SLOPE, ON EDGE OF PRIVATE CLEAR CUT UNIT FOLLOW 1610-370 ROAD TO POSTED PROPERTY LINE IN CENTER OF SECTION 28, FOLLOW POSTED/BLAZED LINE SOUTH 500 FEET +/- TO CORNER

Signature \_\_\_\_\_ Title \_\_\_\_\_ Division \_\_\_\_\_ Headquarters \_\_\_\_\_ Date 7100-52 (3/68)

CORNER RECORD (PERPETUATION)

MONUMENT : DESCRIBE NEW MONUMENT SET, OR WORK DONE TO PRESERVE EXISTING MONUMENT  
 BRUSH CLEARED AROUND MONUMENT AND TO BT'S  
 "LAND LINE" FLAGGING TIED ON MONUMENT AND GUARD POSTS

**REGISTERED PROFESSIONAL LAND SURVEYOR**  
*John Ransom*  
**OREGON**  
 JULY 21, 1902  
**JOHN C. RANSOM**  
 2561

ACCESSORIES : DESCRIBE NEW BT'S WITNESS OBJECTS ETC. ESTABLISHED, OR WORK DONE TO PRESERVE EXISTING EVIDENCE  
 NO NEW ACCESSORIES ADDED  
 NEW NAILS IN BT TAGS AND PAINTED FACES & 6 INCH BAND AT HEAD HEIGHT

DONE BY: Jonathan Drew TITLE LSIT DATE 11/25/2013 PLS NO./AGENCY/STATE JOHN RANSOM, PLS2561  
 Certified Cor. Record Prepared? NO Filed At: \_\_\_\_\_ DATE \_\_\_\_\_

REMARKS  
 PROPERTY LINE MAINTINED NORTH 1 MILE AND EAST .5 MILES

Index File No T-11 T. 31 S R. 1 W M. WM Proj No. ELK Cor. C 1/4

C.S. File No 65/85-15