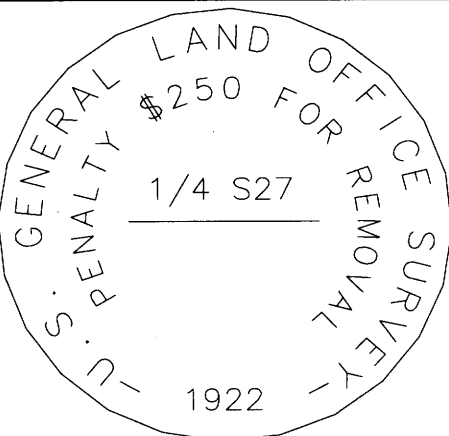


Index


CORNER RECORD (SEARCH)

File No. V-15.01 PROJ. NO. ELK CORNER 1/4 S 27
 TOWNS. 31 S RANGE 1 W R.D. TILLER COUNTY DOUGLAS GCDB# 440200
 MERID. WM FOREST UMPQUA STATE OREGON

CORNER DIAGRAM 	DESCRIBE CORNER MONUMENT FOUND FOUND 2-1/2" BRASS CAP ON 1" IRON PIPE, PROJECTING 10 INCHES ABOVE THE GROUND.																				
Obj. Ident. Ident. By _____ Signature _____	DESCRIBE BEARING TREES OR OTHER OFFICIAL ACCESSORIES FOUND <table border="1"> <thead> <tr> <th>DIA</th> <th>TYPE</th> <th>BEARS</th> <th>DIST</th> <th>FACE/MARKINGS</th> </tr> </thead> <tbody> <tr> <td>23"</td> <td>FIR</td> <td>(N19W)</td> <td>(11.4 FT)</td> <td>HEALED DOUBLE BLAZE</td> </tr> <tr> <td>27"</td> <td>FIR</td> <td>(N65W)</td> <td>(35.3 FT)</td> <td>HEALED DOUBLE BLAZE</td> </tr> <tr> <td>2.5"</td> <td colspan="4">BRASS CAP (N88°05'W) (49.05 FT) 1/4 S34 ONLY GLO CAP PER M58-7</td> </tr> </tbody> </table> <p>() = RECORD PER M58-7</p>	DIA	TYPE	BEARS	DIST	FACE/MARKINGS	23"	FIR	(N19W)	(11.4 FT)	HEALED DOUBLE BLAZE	27"	FIR	(N65W)	(35.3 FT)	HEALED DOUBLE BLAZE	2.5"	BRASS CAP (N88°05'W) (49.05 FT) 1/4 S34 ONLY GLO CAP PER M58-7			
DIA	TYPE	BEARS	DIST	FACE/MARKINGS																	
23"	FIR	(N19W)	(11.4 FT)	HEALED DOUBLE BLAZE																	
27"	FIR	(N65W)	(35.3 FT)	HEALED DOUBLE BLAZE																	
2.5"	BRASS CAP (N88°05'W) (49.05 FT) 1/4 S34 ONLY GLO CAP PER M58-7																				
PLANE COORDINATE POSITION DATA State _____ Zone _____ North _____ West _____ Estab. By _____ Signature _____	DESCRIBE CORNER LOCATION RELATIVE TO NEAR-BY FEATURES, ALSO HOW TO REACH CORNER CORNER FALLS ON SLIGHT WEST SLOPE, JUST SOUTH OF OLD BARBED WIRE FENCE, ON EDGE OF TIMBER LINE WITH OLD GROWTH TO THE NORTH. TO FIND CORNER, TAKE 1610-370 ABOUT 500 FT PAST THE 378 SPUR, GO SOUTH ON OLD OVERGROWN ROAD ABOVE ROCK EROSION CONTROL ON EDGE OF ROAD, FOLLOW OLD ROAD TO POSTED LINE, THEN EAST ON LINE.																				

Signature _____ Title _____ Division _____ Headquarters _____ Date 7100-52 (3/68)

CORNER RECORD (PERPETUATION)

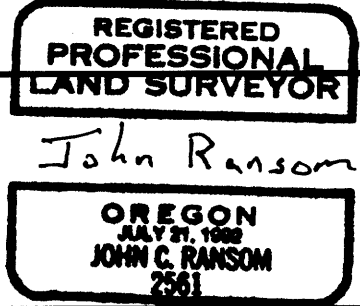

MONUMENT : DESCRIBE NEW MONUMENT SET, OR WORK DONE TO PRESERVE EXISTING MONUMENT

BRUSH CLEARED AROUND MONUMENT AND TO BT'S
 "LAND LINE" FLAGGING TIED ON MONUMENT AND GUARD POSTS

ACCESSORIES : DESCRIBE NEW BT'S WITNESS OBJECTS ETC. ESTABLISHED, OR WORK DONE TO PRESERVE EXISTING EVIDENCE

NO NEW ACCESSORIES ADDED
 NEW NAILS IN BT TAGS AND PAINTED FACES & 6 INCH BAND AT HEAD HEIGHT

DONE BY: Jonathan Drew TITLE LSIT DATE 1/7/2013 PLS NO./AGENCY/STATE JOHN RANSOM, PLS2561
 Certified Cor. Record Prepared? NO Filed At: _____ DATE _____

REMARKS

PROPERTY LINE MAINTINED WEST 1700 FT +/- AND EAST .5 MILE

Index File No V-15.01 T. 31 S R. 1 W M. WM Proj No. ELK Cor. 1/4 S 27

C.S. File No 65/85-22