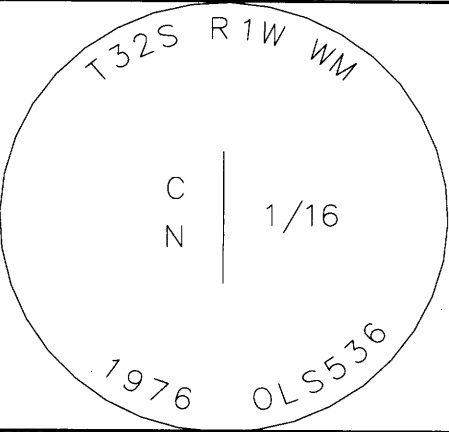


Index **CORNER RECORD (SEARCH)**
 File No. 0-3 PROJ. NO. ELK CORNER CN 1/16
 TOWNS. 32 S RANGE 1 W R.D. TILLER COUNTY DOUGLAS GCDB# 140360
 MERID. WM FOREST UMPQUA STATE OREGON

CORNER DIAGRAM 	DESCRIBE CORNER MONUMENT FOUND FOUND 3" BRASS CAP ON 2-1/2" IRON PIPE, PROJECTING 2 INCHES ABOVE A MOUND OF STONE DESCRIBE BEARING TREES OR OTHER OFFICIAL ACCESSORIES FOUND <table border="1" style="width:100%; border-collapse: collapse;"> <thead> <tr> <th>DIA</th> <th>TYPE</th> <th>BEARS</th> <th>DIST</th> <th>FACE/MARKINGS</th> </tr> </thead> <tbody> <tr> <td>28"</td> <td>FIR</td> <td>(S76E)</td> <td>(40.1 FT)</td> <td>BROKEN TOP FIR HEALED DOUBLE BLAZE</td> </tr> <tr> <td>16"</td> <td>FIR</td> <td>(N36W)</td> <td>(30.6 FT)</td> <td>HEALED DOUBLE BLAZE</td> </tr> </tbody> </table> <p style="text-align: right;">() = RECORD PER 2002 BLM RECORD</p>	DIA	TYPE	BEARS	DIST	FACE/MARKINGS	28"	FIR	(S76E)	(40.1 FT)	BROKEN TOP FIR HEALED DOUBLE BLAZE	16"	FIR	(N36W)	(30.6 FT)	HEALED DOUBLE BLAZE
DIA	TYPE	BEARS	DIST	FACE/MARKINGS												
28"	FIR	(S76E)	(40.1 FT)	BROKEN TOP FIR HEALED DOUBLE BLAZE												
16"	FIR	(N36W)	(30.6 FT)	HEALED DOUBLE BLAZE												
Obj. Ident. _____ Ident. By _____ Signature _____	DESCRIBE CORNER LOCATION RELATIVE TO NEAR-BY FEATURES, ALSO HOW TO REACH CORNER CORNER FALLS ON STEEP EAST SLOPE AT CORNER OF RECENT PRIVATE CLEAR CUT, TAKE HIGHWAY TO PRIVATE LOGGING ROAD JUST SOUTH OF PROPERTY LINE, PARK THERE AND WALK NORTH TO LINE, THEN EAST 400'+/- TO CORNER															
PLANE COORDINATE POSITION DATA State _____ Zone _____ North _____ West _____ Estab. By _____																

Signature _____ Title _____ Division _____ Headquarters _____ Date 7100-52 (3/68)

CORNER RECORD (PERPETUATION)

MONUMENT : DESCRIBE NEW MONUMENT SET, OR WORK DONE TO PRESERVE EXISTING MONUMENT BRUSH CLEARED AROUND MONUMENT AND TO BT'S "LAND LINE" FLAGGING TIED ON MONUMENT AND GUARD POSTS	<div style="border: 2px solid black; padding: 5px; margin-bottom: 10px;"> REGISTERED PROFESSIONAL LAND SURVEYOR </div> <div style="font-family: cursive; font-size: 1.2em; margin-bottom: 10px;"> John Ransom </div> <div style="border: 2px solid black; padding: 5px;"> OREGON JULY 21, 1982 JOHN C. RANSOM 2561 </div>
ACCESSORIES : DESCRIBE NEW BT's WITNESS OBJECTS ETC. ESTABLISHED, OR WORK DONE TO PRESERVE EXISTING EVIDENCE NO NEW ACCESSORIES ADDED NEW NAILS IN BT TAGS AND PAINTED FACES & 6 INCH BAND AT HEAD HEIGHT	
DONE BY: <u>Jonathan Drew</u> TITLE <u>LSIT</u> DATE <u>9/10/2013</u> PLS NO./AGENCY/STATE <u>JOHN RANSOM, PLS2561</u> Certified Cor. Record Prepared? <u>NO</u> Filed At: _____ DATE _____	
REMARKS PROPERTY LINE MAINTINED WEST .25 MILES	

Index File No 0-3 T. 32 S R. 1 W M. WM Proj No. ELK Cor. CN 1/16