


USDA-FOREST SERVICE

Index

CORNER RECORD (SEARCH)

File No. A-7 PROJ. NO. ELK CORNER 1/4 S5
 TOWNS. 32 S RANGE 1 W R.D. TILLER COUNTY DOUGLAS GCDB# 240700
 MERID. W.M. FOREST UMPQUA STATE OREGON

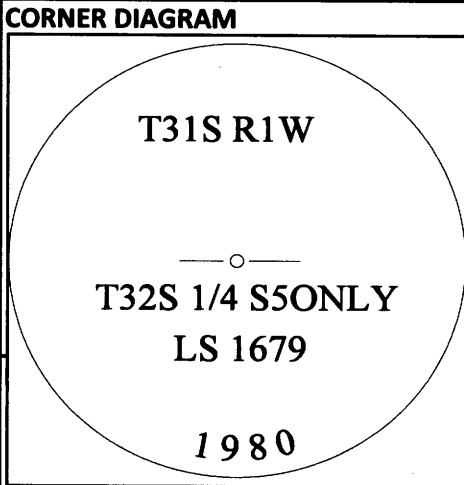

DESCRIBE CORNER MONUMENT FOUND
 FOUND 2-1/2 INCH BRASS CAP ON 2-1/4 INCH IRON PIPE, PROJECTING 3 INCHES ABOVE THE GROUND

DESCRIBE BEARING TREES OR OTHER OFFICIAL ACCESSORIES FOUND

DIA	TYPE	BEARS	DIST	FACE/MARKINGS
13"	FIR	(S38°W)	(15.6 FT)	HEALED SINGLE BLAZE
13"	FIR	(S28°E)	(19.4 FT)	HEALED SINGLE BLAZE

BRASS CAP (S89°20'28"E) (158.46FT) SECTION CORNER FOR 33&32 ONLY

() = RECORD MEASUREMENT PER RM3-37

Obj. Ident. _____
 Ident. By _____
 Signature _____

DESCRIBE CORNER LOCATION RELATIVE TO NEAR-BY FEATURES, ALSO HOW TO REACH CORNER
 CORNER FALLS ON NORTH SLOPE UNDER A BARBED WIRE A FEW FEET EAST OF A LARGE FIR TREE FENCE CORNER. PARK AT DISPURSED CAMPSITE ON SOUTH SIDE OF FS ROAD 150 JUST PRIOR TO FIRST CATTLE GARD, WALK SOUTH TO FENCELINE THEN WEST TO CORNER.

PLANE COORDINATE POSITION DATA
 State _____ Zone _____
 North _____
 West _____
 Estab. By _____

Signature _____ Title _____ Division _____ Headquarters _____

CORNER RECORD (PERPETUATION)

MONUMENT : DESCRIBE NEW MONUMENT SET, OR WORK DONE TO PRESERVE EXISTING MONUMENT
 BRUSH CLEARED AROUND MONUMENT AND TO BT'S
 "LAND LINE" FLAGGING TIED ON MONUMENT AND GUARD POSTS

REGISTERED PROFESSIONAL LAND SURVEYOR

John Ransom

OREGON
 JULY 21, 1992
 JOHN C. RANSOM
 2561

ACCESSORIES : DESCRIBE NEW BT'S WITNESS OBJECTS ETC. ESTABLISHED, OR WORK DONE TO PRESERVE EXISTING EVIDENCE
 NO NEW ACCESSORIES ESTABLISHED
 MEASURE DISTANCE TO SW BT TO DETERMINE WHICH RECORD MATCHES THE TREE BEST. CONFLICTING RECORDS RED PAINT APPLIED TO BT FACES AND A 6" BAND AT HEAD HEIGHT, BT'S INCLUDE BT & SURVEY MONUMENT TAGS

DONE BY: Jonathan Drew TITLE LSIT DATE 12/11/2013 PLS NO./AGENCY/STATE _____
 Certified Cor. Record Prepared? YES Filed At: DOUGLAS CO. DATE _____

REMARKS
 MAINTAIN LINE .5 MILES SOUTH

Index File No A-7 T. 32 S R. 1 W M. W.M. Proj No. ELK Cor. 1/4 S5

C.S. File No 65/85-28