


USDA-FOREST SERVICE

Index

CORNER RECORD (SEARCH)

File No. J-1 PROJ. NO. ELK CORNER SECTION  
 TOWNS. 32 S RANGE 1 W R.D. TILLER COUNTY DOUGLAS GCDB# 100500  
 MERID. W.M. FOREST UMPQUA STATE OREGON

CORNER DIAGRAM

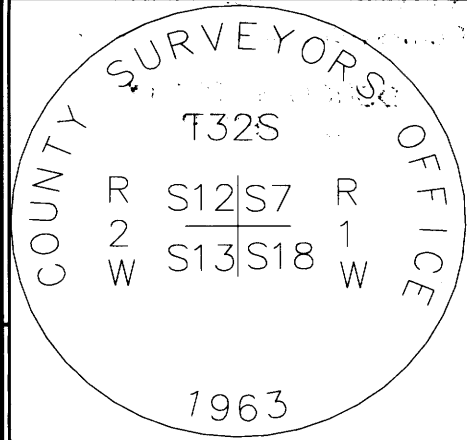

DESCRIBE CORNER MONUMENT FOUND  
 FOUND 2-1/2 INCH BRASS CAP ON 1 INCH IRON PIPE, PROJECTING 12 INCHES ABOVE A 3 FOOT DIAMETER MOUND OF STONE

DESCRIBE BEARING TREES OR OTHER OFFICIAL ACCESSORIES FOUND

DIA	TYPE	BEARS	DIST	FACE/MARKINGS
19"	FIR	S69-1/2°W	40.4 FT	HEALED DOUBLE BLAZE
21"	FIR	N85°W	23.1 FT	HEALED DOUBLE BLAZE
14"	FIR	N7-1/4°E	16.0 FT	HEALED SINGLE BLAZE
24"	FIR	S32-1/4°E	22.1 FT	SCRIBE ON PART. HEALED DOUBLE BLAZE
INDT	FIR STUMP	N27-3/4°W	19.6 FT	AX WORK ON ROTTING STUMP
INDT	ROOT HOLE	N21-1/2°E	50.1 FT	NO LOG FOUND
INDT	ROOT HOLE	N38-3/4°W	48.0 FT	LOG WITH ROTTEN FACE ALONGSIDE
INDT	ROOT HOLE	N61-3/4°E	19.5 FT	SOME REMAINS OF STUMP FOUND

Obj. Ident. \_\_\_\_\_  
 Ident. By \_\_\_\_\_  
 Signature \_\_\_\_\_

DESCRIBE CORNER LOCATION RELATIVE TO NEAR-BY FEATURES, ALSO HOW TO REACH CORNER  
 CORNER FALLS ON NORTH SIDE OF A GRAVELED ROAD, ABOUT 40 FEET FROM CENTERLINE.

PLANE COORDINATE POSITION DATA  
 State \_\_\_\_\_ Zone \_\_\_\_\_  
 North \_\_\_\_\_  
 West \_\_\_\_\_  
 Estab. By \_\_\_\_\_

Signature \_\_\_\_\_ Title \_\_\_\_\_ Division \_\_\_\_\_ Headquarters \_\_\_\_\_

CORNER RECORD (PERPETUATION)

MONUMENT : DESCRIBE NEW MONUMENT SET, OR WORK DONE TO PRESERVE EXISTING MONUMENT

BRUSH CLEARED AROUND MONUMENT AND TO BT'S  
 "LAND LINE" FLAGGING TIED ON MONUMENT AND GUARD POSTS

REGISTERED PROFESSIONAL LAND SURVEYOR

*John Ransom*

OREGON  
 JULY 21, 1992  
 JOHN C. RANSOM  
 2561

ACCESSORIES : DESCRIBE NEW BT'S WITNESS OBJECTS ETC. ESTABLISHED, OR WORK DONE TO PRESERVE EXISTING EVIDENCE

NO NEW ACCESSORIES ESTABLISHED

RED PAINT APPLIED TO BT FACES AND A 6" BAND AT HEAD HEIGHT, BT'S INCLUDE BT & SURVEY MONUMENT TAGS

DONE BY: Jonathan Drew TITLE LSIT DATE 9/11/2013 PLS NO./AGENCY/STATE \_\_\_\_\_

Certified Cor. Record Prepared? YES Filed At: DOUGLAS CO. DATE \_\_\_\_\_

REMARKS

MEASUREMENTS TO ACCESSORIES MADE WITH LEICA 1103+ TOTAL STATION WITH REFLECTORLESS EDM TO ALUMINUM NAIL SET AT SIDE CENTER, AND TO CENTER OF FOUND ROOT HOLES, BASIS OF BEARING BEING PLAT RECORD BEARING(S89°51'50"W) USING STEEL LINE POST FOUND ABOUT 80 FEET WEST OF CORNER. MAINTAINED LINE .5 MILES EAST OF CORNER.

Index File No J-1 T. 32 S R. 1 W M. W.M. Proj No. ELK Cor. SECTION

C.S. File No 65/85-31