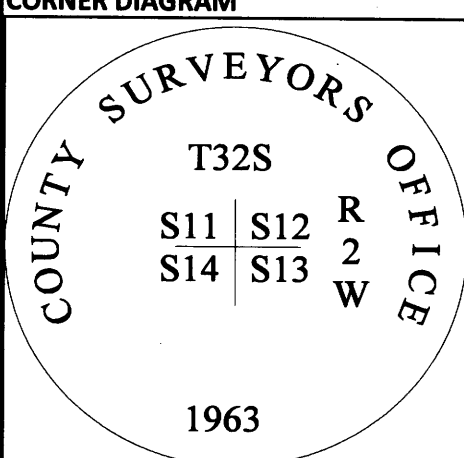


Index **CORNER RECORD (SEARCH)**  
 File No. J-21 PROJ. NO. ELK CORNER SECTION  
 TOWNS. 32 S RANGE 2 W R.D. TILLER COUNTY DOUGLAS GCDB# 600500  
 MERID. W.M. FOREST UMPQUA STATE OREGON

<b>CORNER DIAGRAM</b> 	<b>DESCRIBE CORNER MONUMENT FOUND</b> FOUND 2-1/2 INCH BRASS CAP ON 1 INCH IRON PIPE, PROJECTING 6 INCHES ABOVE A MOUND OF STONE																								
	<b>DESCRIBE BEARING TREES OR OTHER OFFICIAL ACCESSORIES FOUND</b> <table border="1"> <thead> <tr> <th>DIA</th> <th>TYPE</th> <th>BEARS</th> <th>DIST</th> <th>FACE/MARKINGS</th> </tr> </thead> <tbody> <tr> <td>22"</td> <td>FIR</td> <td>N25°45'E</td> <td>37.3 FT</td> <td>HEALED LOWER BLAZE, SCRIBE VISIBLE ON PARTIALLY HEALED UPPER BLAZE</td> </tr> <tr> <td>19"</td> <td>FIR STUMP</td> <td>(S37°W)</td> <td>(66.5 FT)</td> <td>HIGH STUMP, HEALED DOUBLE BLAZE NOT VISIBLE FROM CORNER</td> </tr> <tr> <td>29"</td> <td>ROOT HOLE</td> <td>N65°W</td> <td>68.7 FT</td> <td>HEMLOCK WINDTHROW HEALED DOUBLE BLAZE, LARGE ROOT HOLE</td> </tr> <tr> <td>23"</td> <td>FIR</td> <td>S16°30'E</td> <td>90.0 FT</td> <td>HEALED DOUBLE BLAZE</td> </tr> </tbody> </table>	DIA	TYPE	BEARS	DIST	FACE/MARKINGS	22"	FIR	N25°45'E	37.3 FT	HEALED LOWER BLAZE, SCRIBE VISIBLE ON PARTIALLY HEALED UPPER BLAZE	19"	FIR STUMP	(S37°W)	(66.5 FT)	HIGH STUMP, HEALED DOUBLE BLAZE NOT VISIBLE FROM CORNER	29"	ROOT HOLE	N65°W	68.7 FT	HEMLOCK WINDTHROW HEALED DOUBLE BLAZE, LARGE ROOT HOLE	23"	FIR	S16°30'E	90.0 FT
DIA	TYPE	BEARS	DIST	FACE/MARKINGS																					
22"	FIR	N25°45'E	37.3 FT	HEALED LOWER BLAZE, SCRIBE VISIBLE ON PARTIALLY HEALED UPPER BLAZE																					
19"	FIR STUMP	(S37°W)	(66.5 FT)	HIGH STUMP, HEALED DOUBLE BLAZE NOT VISIBLE FROM CORNER																					
29"	ROOT HOLE	N65°W	68.7 FT	HEMLOCK WINDTHROW HEALED DOUBLE BLAZE, LARGE ROOT HOLE																					
23"	FIR	S16°30'E	90.0 FT	HEALED DOUBLE BLAZE																					
<b>PLANE COORDINATE POSITION DATA</b> State _____ Zone _____ North _____ West _____ Estab. By _____	<b>DESCRIBE CORNER LOCATION RELATIVE TO NEAR-BY FEATURES, ALSO HOW TO REACH CORNER</b> CORNER FALLS NORTH 80' FROM CENTERLINE OF A CLOSED LOGGING ROAD(FS RD 1616-160) TAKE FS RD 1616 TO CLOSED ROAD, WALK UP OLD ROAD TO WHAT IS NOW A CLEAR CUT TIMBER EDGE ON PRIVATE.																								

Signature \_\_\_\_\_ Title \_\_\_\_\_ Division \_\_\_\_\_ Headquarters \_\_\_\_\_

**CORNER RECORD (PERPETUATION)**

**MONUMENT : DESCRIBE NEW MONUMENT SET, OR WORK DONE TO PRESERVE EXISTING MONUMENT**

BRUSH CLEARED AROUND MONUMENT AND TO BT'S  
 "LAND LINE" FLAGGING TIED ON MONUMENT AND GUARD POSTS

REGISTERED PROFESSIONAL LAND SURVEYOR

*John Ransom*

OREGON  
 JULY 21, 1992  
 JOHN C. RANSOM  
 2561

**ACCESSORIES : DESCRIBE NEW BT'S WITNESS OBJECTS ETC. ESTABLISHED, OR WORK DONE TO PRESERVE EXISTING EVIDENCE**

SET:  
 A 2" ALUMINUM CAP ON 5/8" REBAR PROJECTING 7" ABOVE GROUND, BEARS S12°W - 21.88 FT, MARKED RM1  
 A 2" ALUMINUM CAP ON 5/8" REBAR PROJECTING 6" ABOVE GROUND, BEARS N38°45'W - 25.20 FT, MARKED RM2  
 CAPS BOTH MARKED "PLS 2561" "2013" WITH CENTER PUNCH  
 RED PAINT APPLIED TO BT FACES AND A 6" BAND AT HEAD HEIGHT, BT'S INCLUDE BT & SURVEY MONUMENT TAGS

DONE BY: Jonathan Drew TITLE LSIT DATE 12/11/2013 PLS NO./AGENCY/STATE \_\_\_\_\_  
 Certified Cor. Record Prepared? YES Filed At: DOUGLAS CO. DATE \_\_\_\_\_

**REMARKS**

MEASUREMENTS TO ACCESSORIES MADE WITH LEICA 1103+ TOTAL STATION WITH REFLECTORLESS EDM TO ALUMINUM NAIL SET AT SIDE CENTER, AND TO CENTER OF FOUND ROOT HOLES, BASIS OF BEARING BEING (M56-73) PLAT RECORD BEARING(N00°02'16"W) USING STEEL LINE POST FOUND ABOUT 50 FEET NORTH OF CORNER. MAINTAINED LINE .25 MILES NORTH AND .5 MILES SOUTH OF CORNER.

Index File No J-21 T. 32 S R. 2 W M. W.M. Proj No. ELK Cor. SECTION

C.S. File No 65/85-34