


Index

CORNER RECORD (SEARCH)

File No. L-23 PROJ. NO. ELK CORNER C 1/4
 TOWNS. 32 S RANGE 2 W R.D. TILLER COUNTY DOUGLAS GCDB# 640440
 MERID. W.M. FOREST UMPQUA STATE OREGON

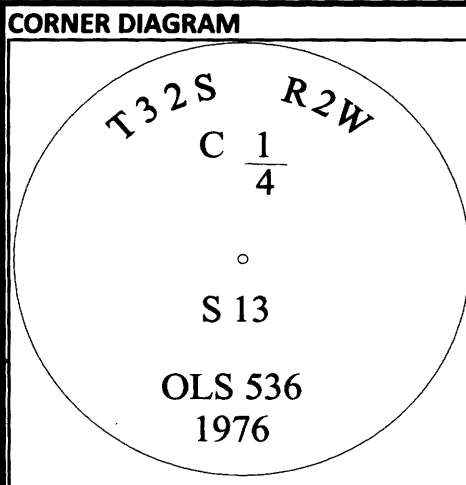

DESCRIBE CORNER MONUMENT FOUND
 FOUND 3 INCH BRASS CAP ON 2-3/4 INCH IRON PIPE, PROJECTING 3 INCHES ABOVE A SMALL MOUND OF STONE

DESCRIBE BEARING TREES OR OTHER OFFICIAL ACCESSORIES FOUND

DIA	TYPE	BEARS	DIST	FACE/MARKINGS
26"	FIR STUMP	N20°30'E	11.3 FT	SAWN STUMP, HEALED DOUBLE BLAZE MEASURE TO MAG NAIL FLUSH IN TOP
27"	FIR	S9°W	43.8 FT	HEALED DOUBLE BLAZE

Obj. Ident. _____
 Ident. By _____

DESCRIBE CORNER LOCATION RELATIVE TO NEAR-BY FEATURES, ALSO HOW TO REACH CORNER
 CORNER FALLS APPROX 80 FEET NORTH FROM CENTERLINE OF A GRAVELED ROAD(FS RD 1616-140) TAKE FS RD 1616 TO GATE, GET KEY FROM HANCOCK TIMBER MANAGEMENT COMPANY IN MEDFORD. TAKE ROAD TO TIMBER CORNER, S9°W BT IS VISIBLE FROM ROAD, CORNER FALLS IN A VINE MAPLE PATCH IN A SWAMPY AREA

PLANE COORDINATE POSITION DATA
 State _____ Zone _____
 North _____
 West _____
 Estab. By _____

Signature _____ Title _____ Division _____ Headquarters _____

CORNER RECORD (PERPETUATION)

MONUMENT : DESCRIBE NEW MONUMENT SET, OR WORK DONE TO PRESERVE EXISTING MONUMENT
 BRUSH CLEARED AROUND MONUMENT AND TO BT'S
 "LAND LINE" FLAGGING TIED ON MONUMENT AND GUARD POSTS

REGISTERED PROFESSIONAL LAND SURVEYOR
John Ransom
 OREGON
 JULY 21, 1992
 JOHN C. RANSOM
 2561

ACCESSORIES : DESCRIBE NEW BT'S WITNESS OBJECTS ETC. ESTABLISHED, OR WORK DONE TO PRESERVE EXISTING EVIDENCE
 MARKED:
 A 32" FIR DOUBLE TREE BEARS, S18°15'E - 41.8 FT, SCRIBED "C1/4S13""BT" ON A DOUBLE BLAZE
 A 7" FIR BEARS, S46°W - 27.5 FT, SCRIBED "X" "BT" ON A DOUBLE BLAZE.
 BT'S INCLUDE 3/4" BRASS WASHER MARKED "LS2561" BETWEEN B & T ON LOWER BLAZE
 RED PAINT APPLIED TO BT FACES AND A 6" BAND AT HEAD HEIGHT, BT'S INCLUDE BT & SURVEY MONUMENT TAGS

DONE BY: Jonathan Drew TITLE LSIT DATE 12/11/2013 PLS NO./AGENCY/STATE _____
 Certified Cor. Record Prepared? YES Filed At: DOUGLAS CO. DATE _____

REMARKS
 MEASUREMENTS TO ACCESSORIES MADE WITH LEICA 1103+ TOTAL STATION WITH REFLECTORLESS EDM TO ALUMINUM NAIL SET AT SIDE CENTER, BASIS OF BEARING BEING PLAT RECORD BEARING(N00°02'56"W) (M56-68) USING STEEL LINE POST FOUND ABOUT 103 FEET NORTH OF CORNER.
 MAINTAINED LINE .5 MILES NORTH OF CORNER.

Index File No L-23 T. 32 S R. 2 W M. W.M. Proj No. ELK Cor. C 1/4

C.S. File No 65/85-36