


Index

CORNER RECORD (SEARCH)

File No. J-23 PROJ. NO. ELK CORNER 1/4
TOWNS. 32 S RANGE 2 W R.D. TILLER COUNTY DOUGLAS GCDB# 640500
MERID. WM FOREST UMPQUA STATE OREGON

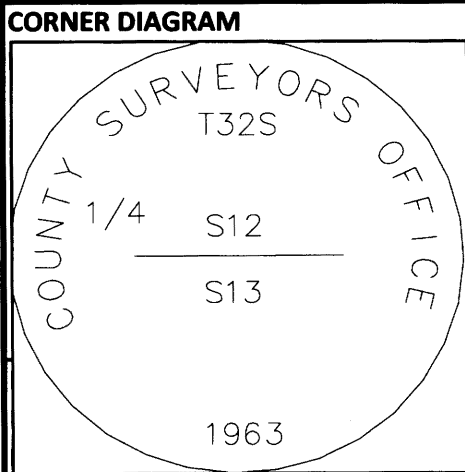

DESCRIBE CORNER MONUMENT FOUND
FOUND 2-1/2" DCSO BRASS CAP ON 1" IRON PIPE, PROJECTING 4 INCHES ABOVE A MOUND OF STONE

DESCRIBE BEARING TREES OR OTHER OFFICIAL ACCESSORIES FOUND
DIA TYPE BEARS DIST FACE/MARKINGS
28" FIR (N60W) (100.0 FT) HEALED DOUBLE BLAZE
30" FIR (S1W) (44.5 FT) HEALED DOUBLE BLAZE
INDT FIR STUMP (S50E) (29.0 FT) DECAYED STUMP, DETACHED FACE
( ) = RECORD PER 1976 M56-68

Obj. Ident.
Ident. By
Signature

DESCRIBE CORNER LOCATION RELATIVE TO NEAR-BY FEATURES, ALSO HOW TO REACH CORNER
CORNER FALLS ON LEVEL GROUND, ABOUT 75 FT SOUTH OF FS ROAD 1616 TAKE 1616 ROAD TO 1616-150 SPUR, PARK AT INTERSECTION, WEST BT FALLS ON WEST SIDE OF 1616-150 SPUR

PLANE COORDINATE POSITION DATA
State Zone
North
West
Estab. By

Signature Title Division Headquarters Date 7100-52 (3/68)

CORNER RECORD (PERPETUATION)

MONUMENT : DESCRIBE NEW MONUMENT SET, OR WORK DONE TO PRESERVE EXISTING MONUMENT
BRUSH CLEARED AROUND MONUMENT AND TO BT'S
"LAND LINE" FLAGGING TIED ON MONUMENT AND GUARD POSTS

REGISTERED PROFESSIONAL LAND SURVEYOR
John Ransom
OREGON JULY 21, 1982 JOHN C. RANSOM 2561

ACCESSORIES : DESCRIBE NEW BT'S WITNESS OBJECTS ETC. ESTABLISHED, OR WORK DONE TO PRESERVE EXISTING EVIDENCE
NO NEW ACCESSORIES ADDED
NEW NAILS IN BT TAGS AND PAINTED FACES & 6 INCH BAND AT HEAD HEIGHT

DONE BY: Jonathan Drew TITLE LSIT DATE 9/10/2013 PLS NO./AGENCY/STATE JOHN RANSOM, PLS2561
Certified Cor. Record Prepared? NO Filed At: DATE

REMARKS
PROPERTY LINE MAINTINED EAST .5 MILES AND SOUTH .5 MILES