

CORNER REPORT FORM

FILED

Section 14 Township 32 Range 8  
Douglas County Date 8/2014  
PLSS Number 540500

Date: 8-7-2014 By: JC  
This survey consists of:  
Map: \_\_\_\_\_  
Narrative: \_\_\_\_\_  
Corner Rpt: CS 65/86-1

DOUGLAS COUNTY  
SURVEYOR

CORNER DESIGNATION

1/4 COR S11  
S14

- Condition report only
- Not Found
- Renewed
- Unrecorded
- Surveyed In
- Referenced out


Previous Renewals/Surveys, etc:

BLM RESURVEY 1975

Monument(s) & Accessories Found: (Condition and Source)

FD BLM BRASS CAP  
8" FIR N65E 37 1/2 FT DEAD & BURNT.  
13" X 2" TAIL STUMP S29W 32 1/2 BURNT.

Monument Detail

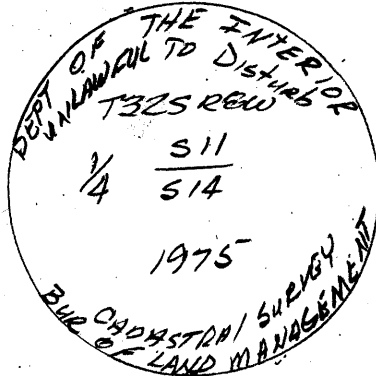

Sketch

Monument Set (Procedures and Description)

New Accessories SET 4 IRROO with Plastic CAP

North 3.0 FT  
East 5.0 FT  
South 2.0 FT  
West 5.0 FT


Surveyor's Seal

Location & Comments

AREA badly BURNT  
7/2013

Compass Declination 15 1/2  
Firm/Agency: IEEHG  
Address: \_\_\_\_\_

Party Chief: N. F. Fowdahl  
Notes: \_\_\_\_\_  
Witness: K. Olson

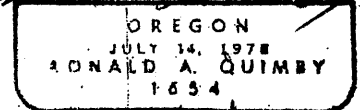

C.S. File 65/86-1