

CORNER REPORT FORM

FILED

Section 14
Douglas County
PLSS Number
560500

Township 32S Range 8W
Date 8/2014

Date: 8/7/2014 By: JC
This survey consists of:
Map:
Narrative:
Corner Rpt: CS 65/86-3

DOUGLAS COUNTY
SURVEYOR

CORNER DESIGNATION

E 1/16 511
514

- Condition report only
- Not Found
- Renewed
- Unrecorded
- Surveyed In
- Referenced out


Previous Renewals/Surveys, etc:

BLM Resurvey 1975 P315984

Monument(s) & Accessories Found: (Condition and Source)

BLM BRASS CAP
24" SUGAR PINE S48E 9.2 FT GOOD SCAR
18" FIR N42E 31.7 F GOOD SCAR

Monument Detail

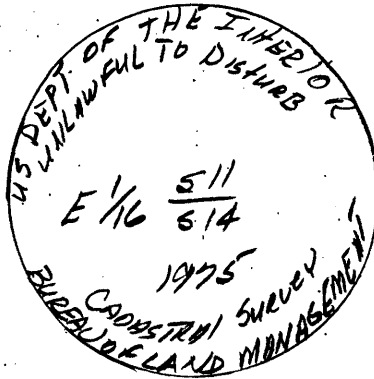

Sketch

Monument Set (Procedures and Description)

New Accessories


Location & Comments

AREA BURNED
7/2013

Compass Declination 15 1/2'
Firm/Agency: LCCM
Address:

Party Chief: N. GONDUBI
Notes:
Witness: R. OLSEN

Surveyor's Seal

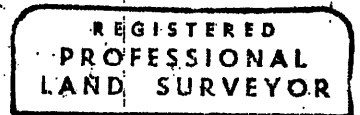

C.S. File 65/86-3